



TOTAL SF AVAILABLE - 10,515 RSF (12.5%)

[Click to access 3D model](#)

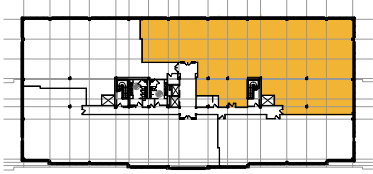

Key Plan

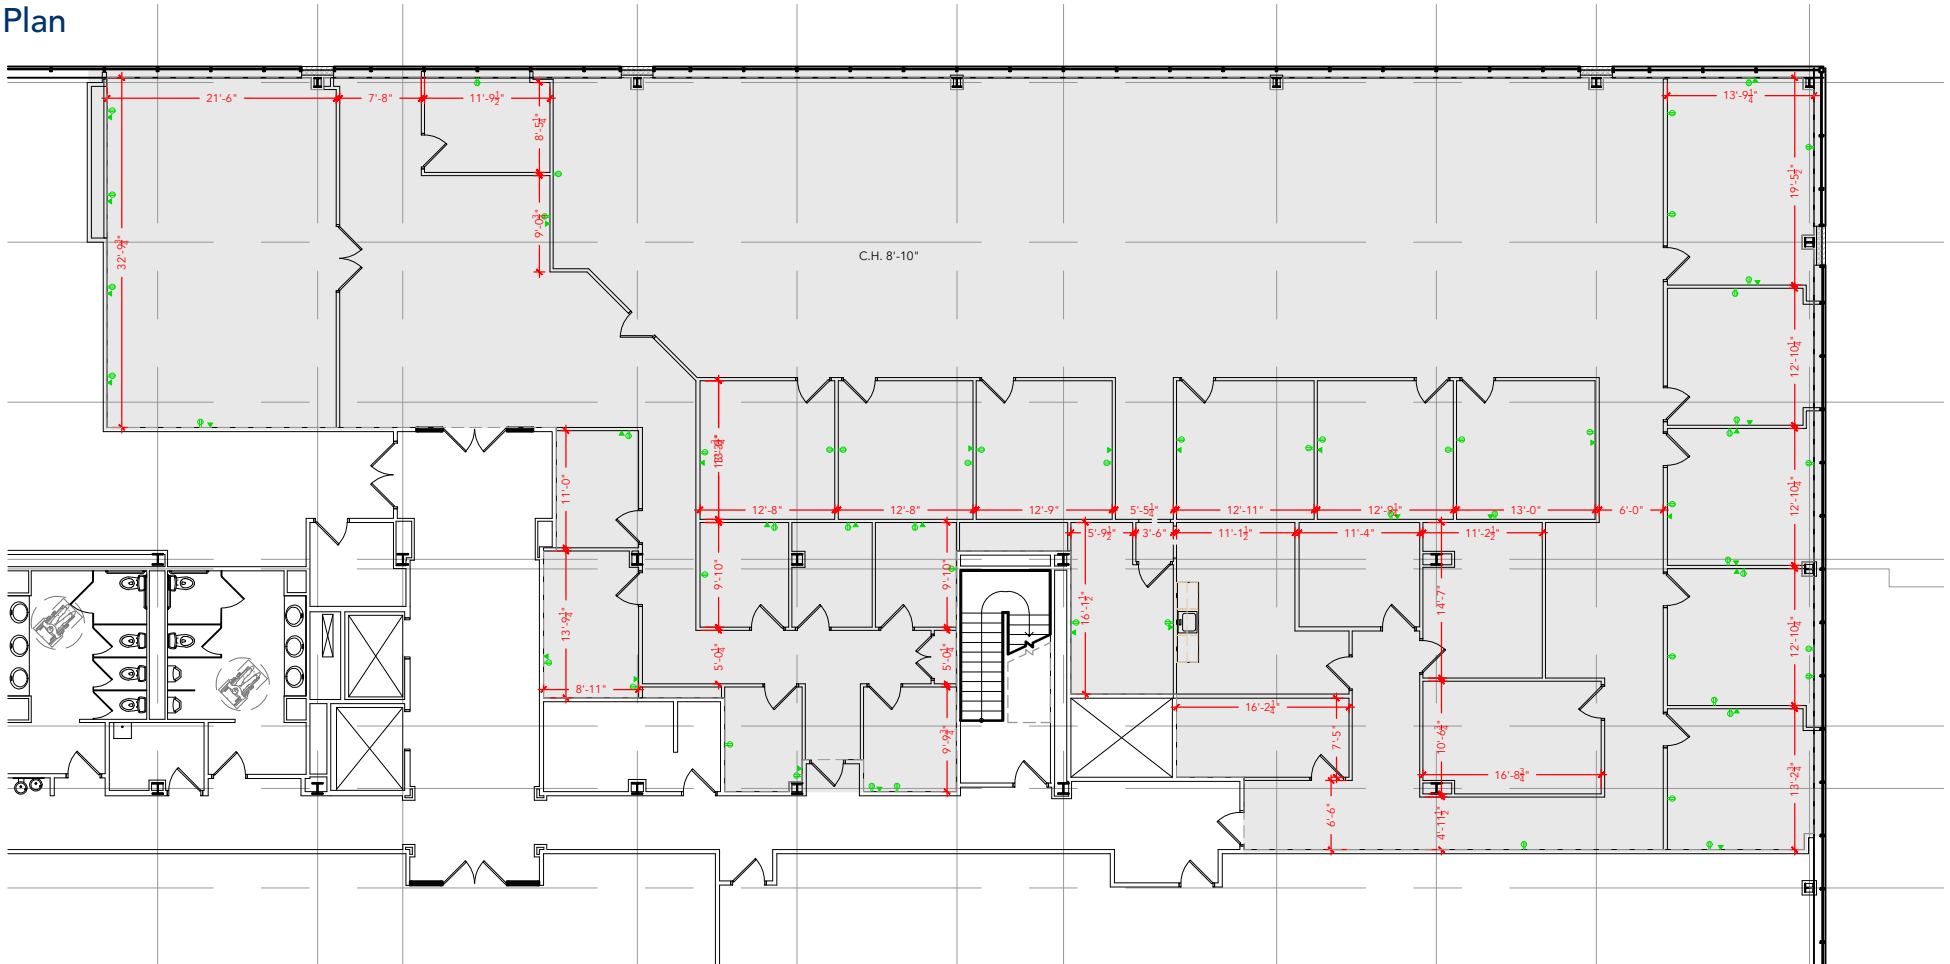

Floor Plan