


TOTAL SF AVAILABLE -5,981 RSF(16%)



[Click to access 3D model](#)

Key Plan

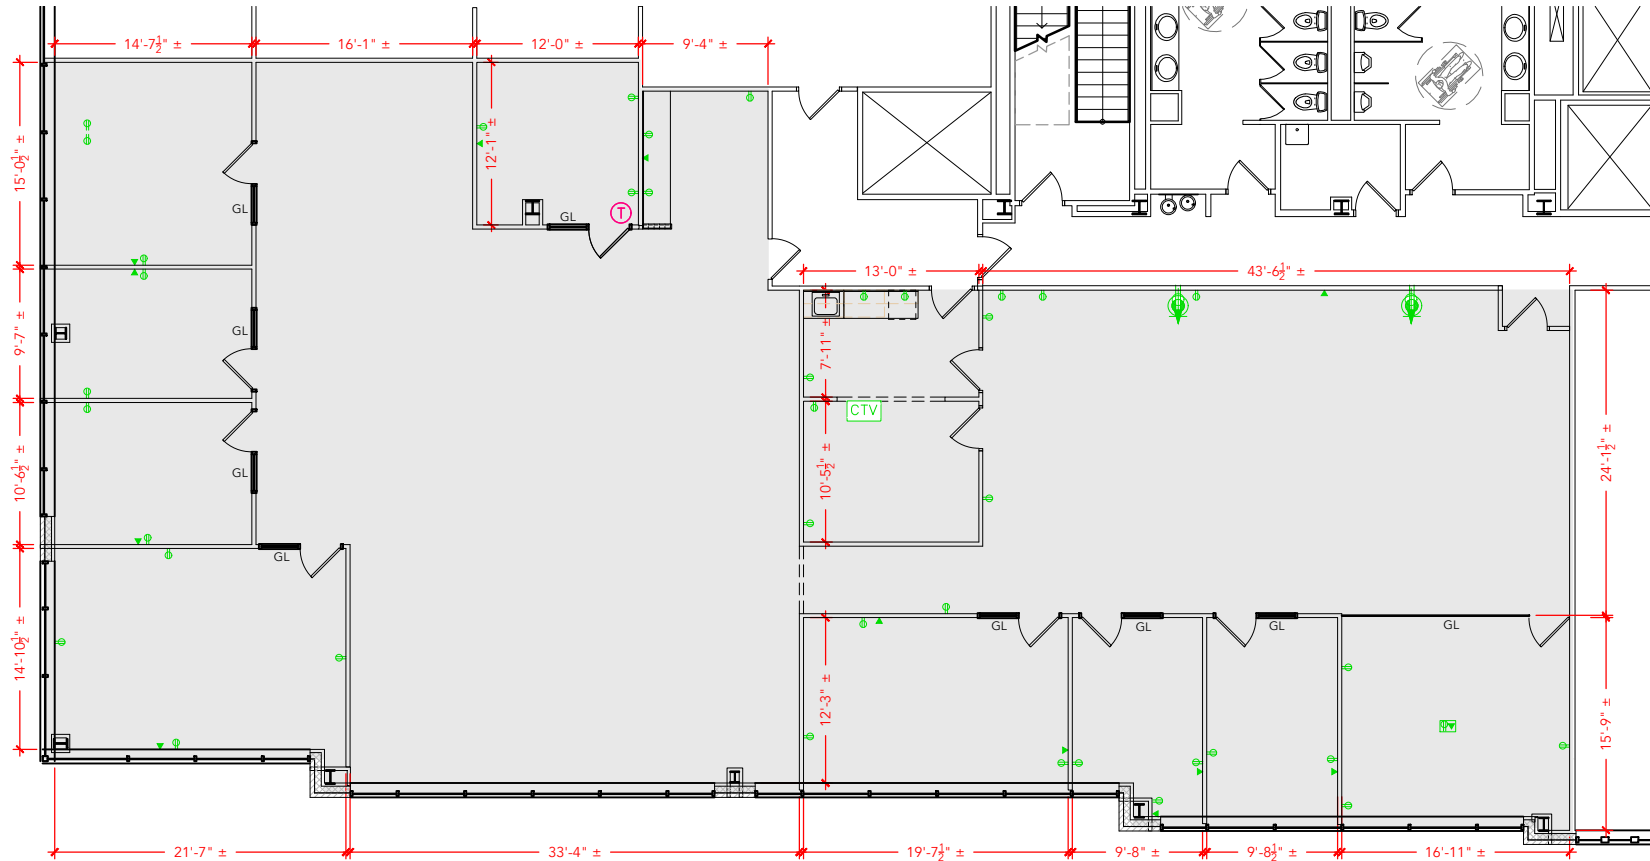

Floor Plan