



TOTAL SF AVAILABLE -5,705 RSF (16%)

[Click to access CADD file](#)

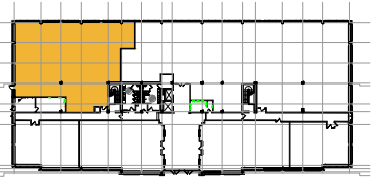

Key Plan

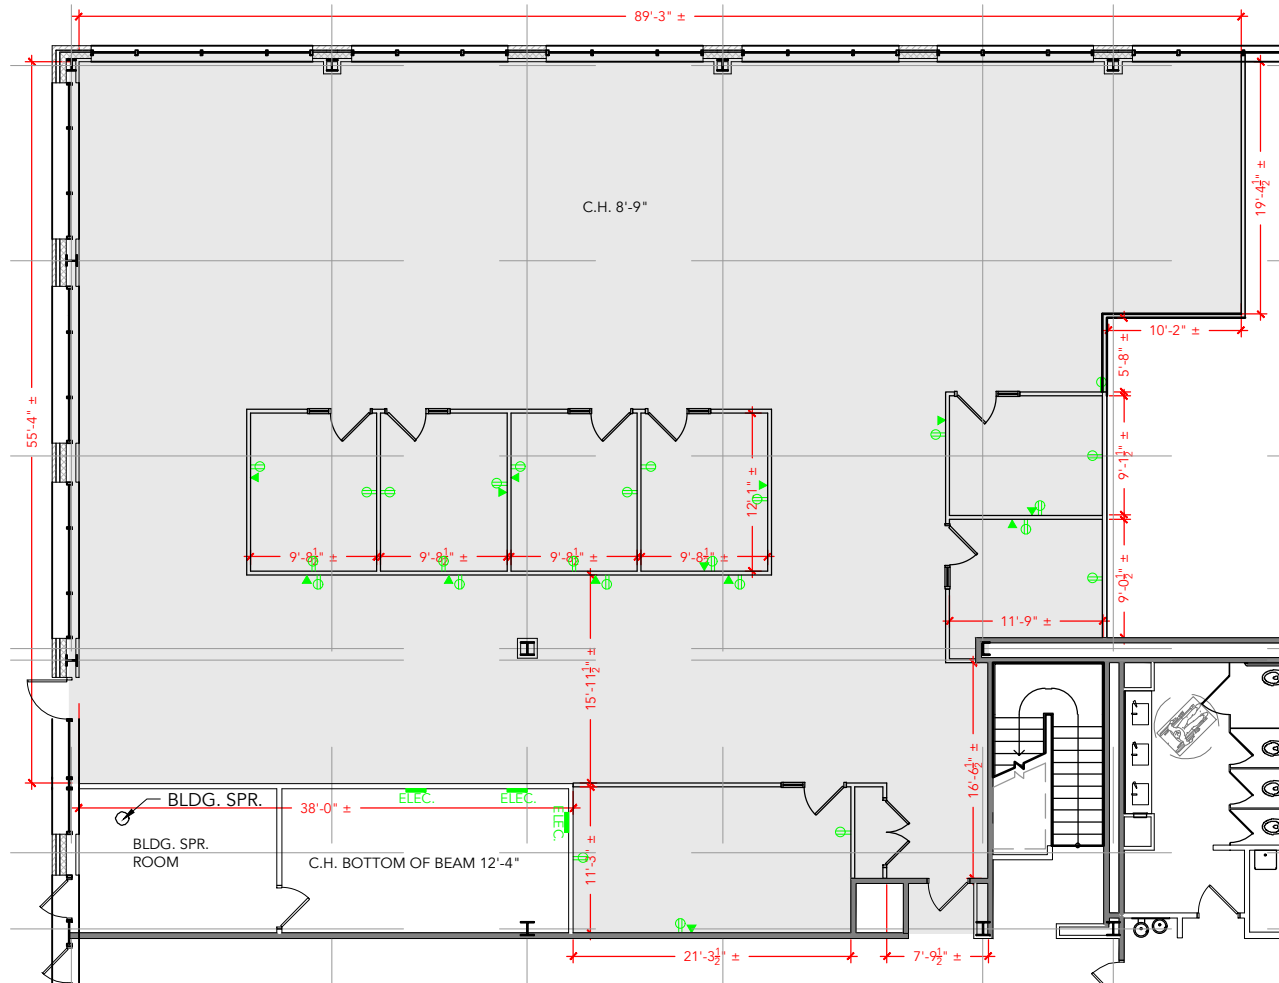

Floor Plan