


TOTAL SF AVAILABLE - 2,780 RSF(12.5%)

[Click to access 3D model](#)



Key Plan

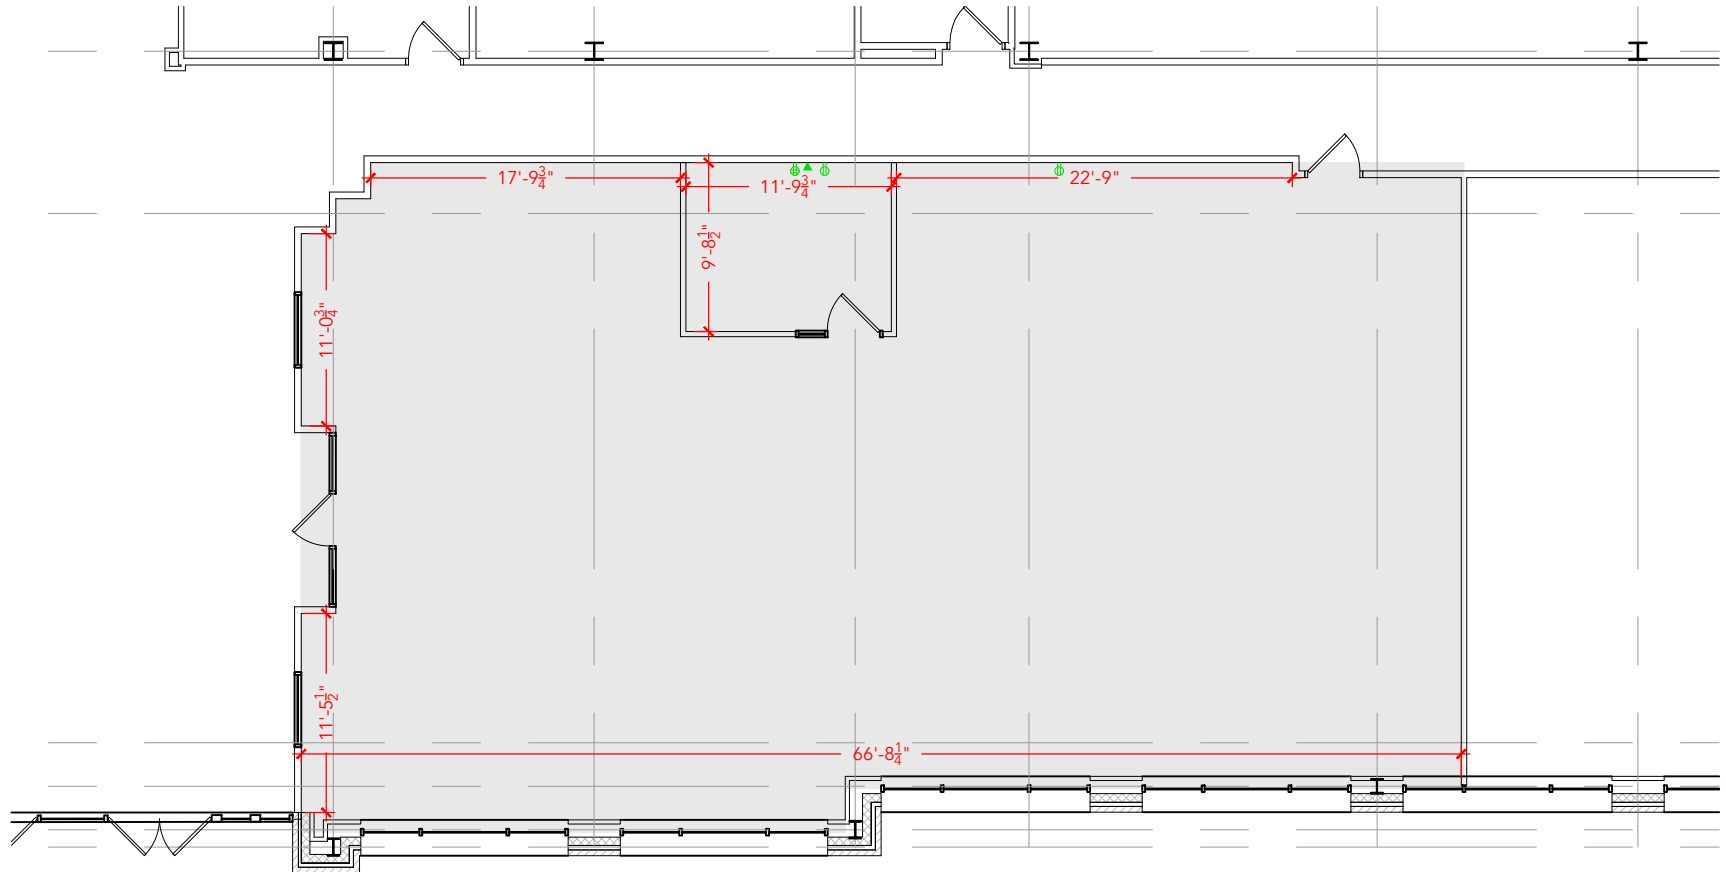

## Floor Plan