


TOTAL SF AVAILABLE - 11,770 RSF(16%)

[Click to access CADD file](#)

Key Plan

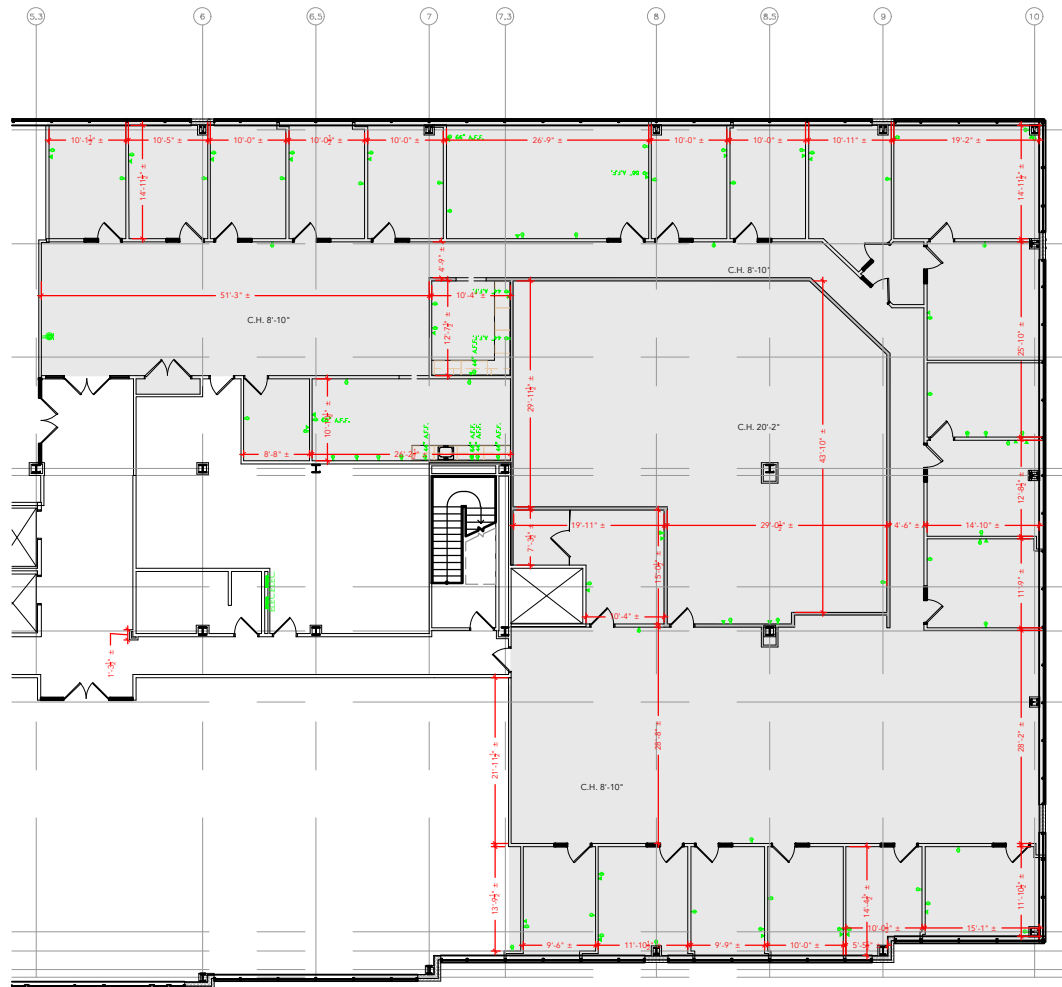

Floor Plan