
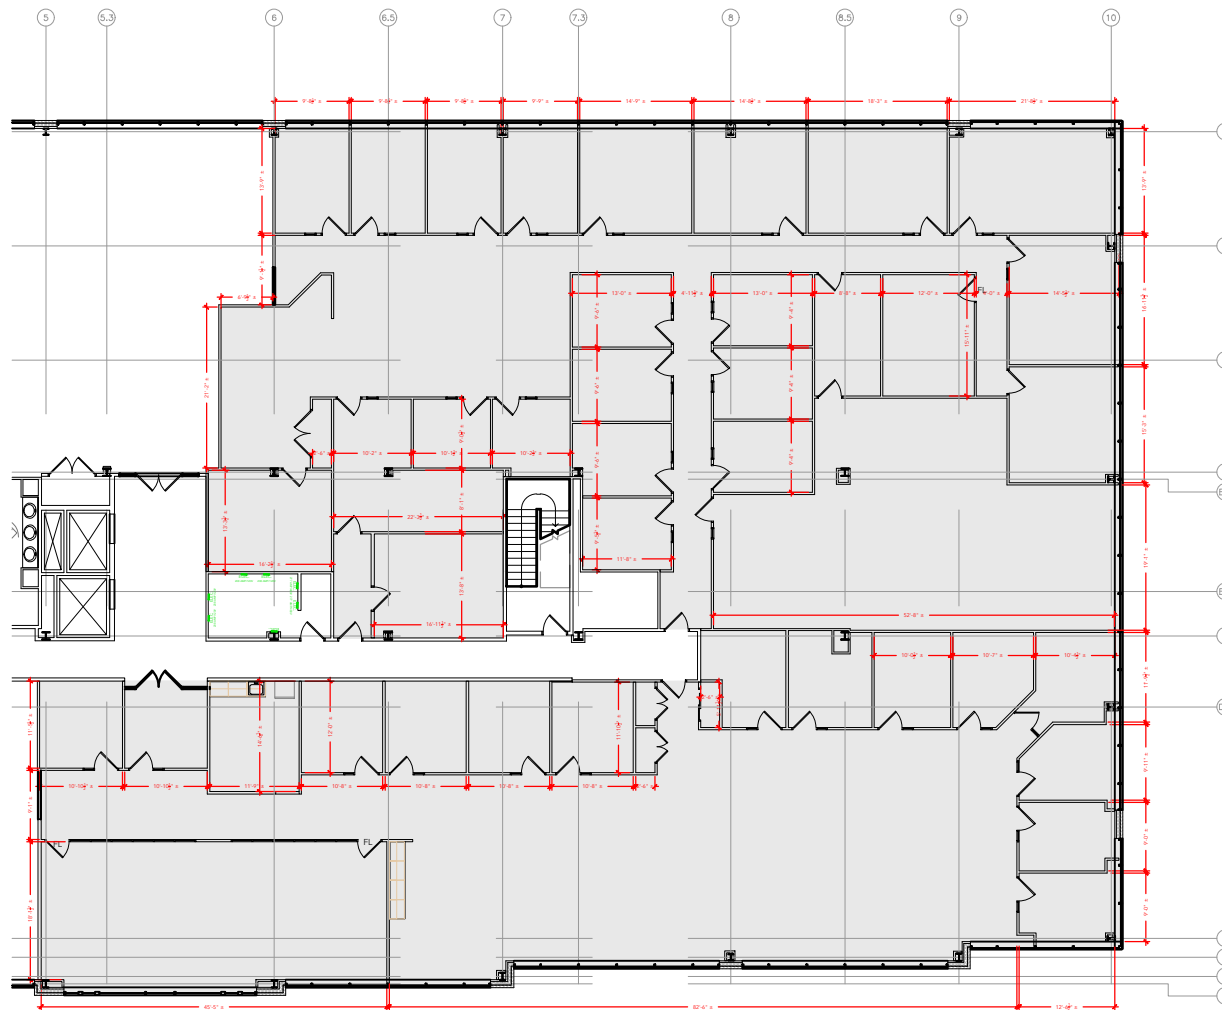


TOTAL SF AVAILABLE -15,306 RSF (16%)

[Click to access 3D model](#)

Key Plan

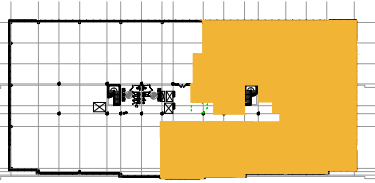

Floor Plan