


TOTAL SF AVAILABLE -51,472 RSF(12%)

OFFICE - 47,089 RSF(12%)

PROP. CIRC. - 4,383 RSF(12%)

[Click to access CADD file](#)

Key Plan

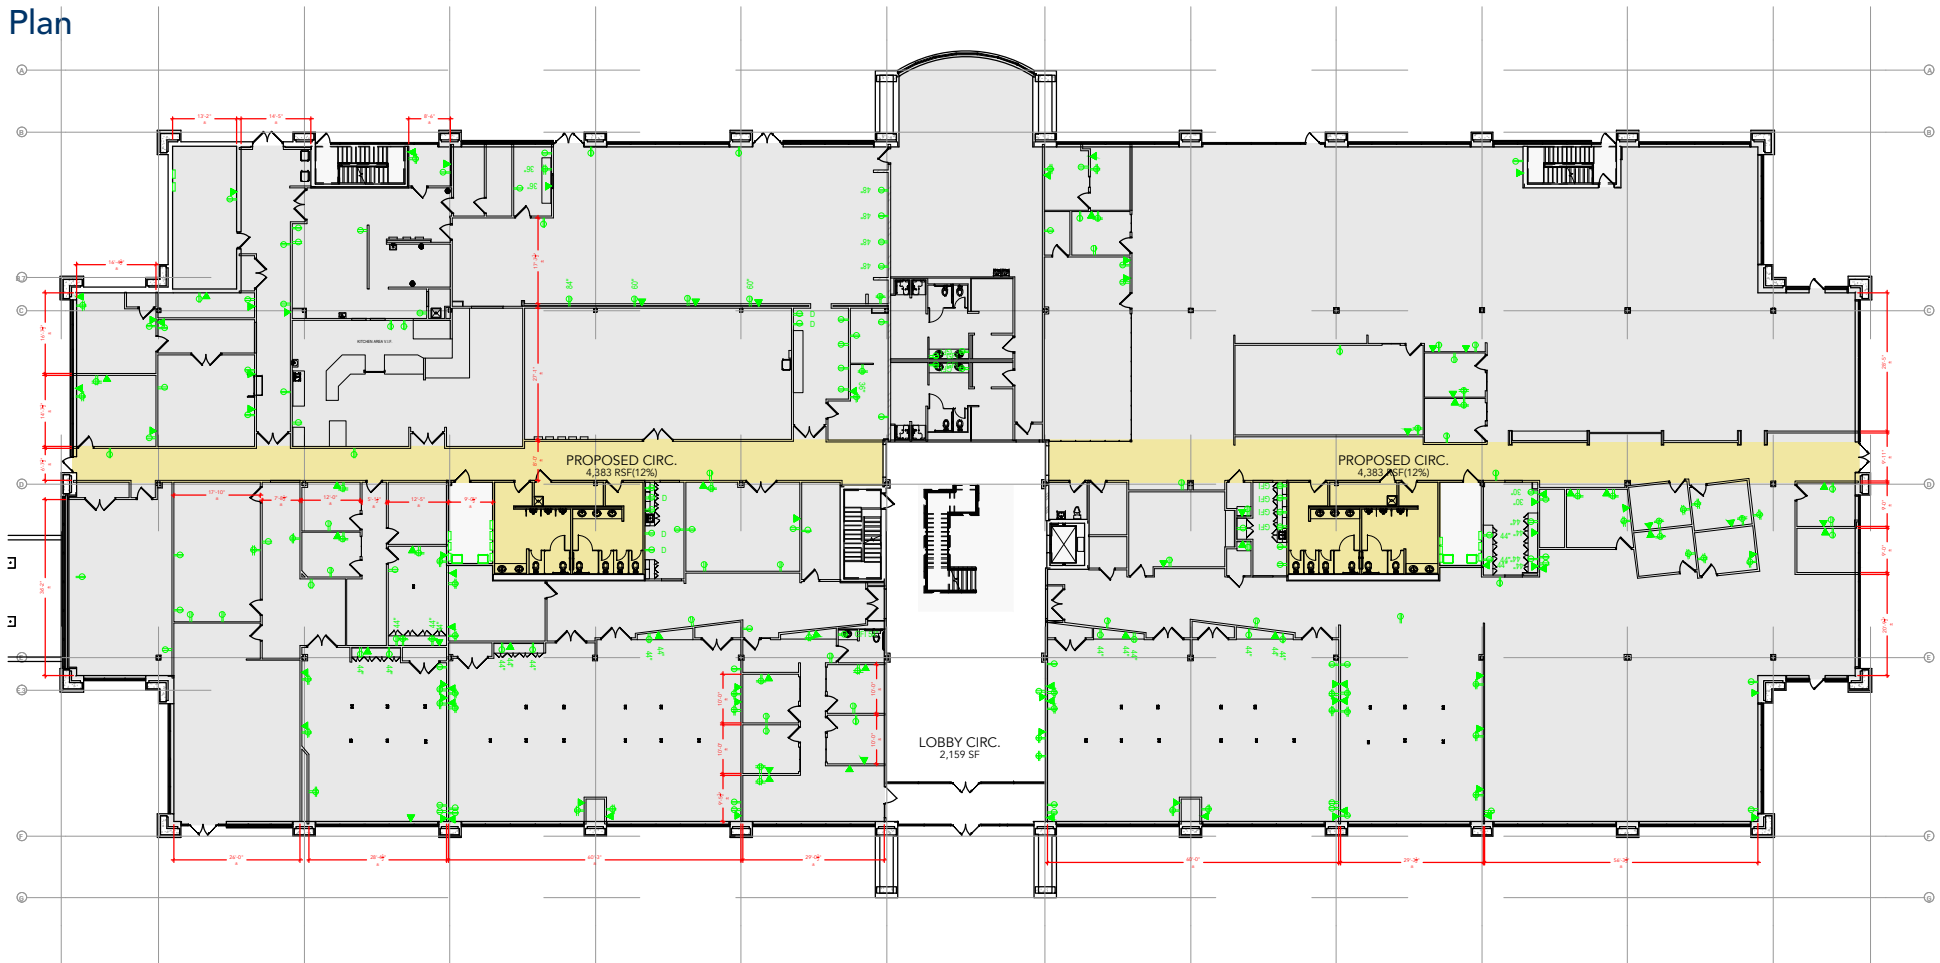

Floor Plan