



TOTAL SF AVAILABLE -55,031 RSF(9%)

[Click to access 3D model](#)

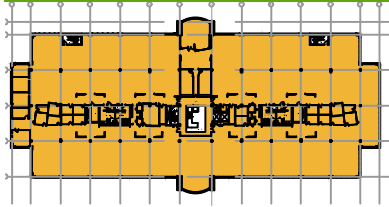

Key Plan

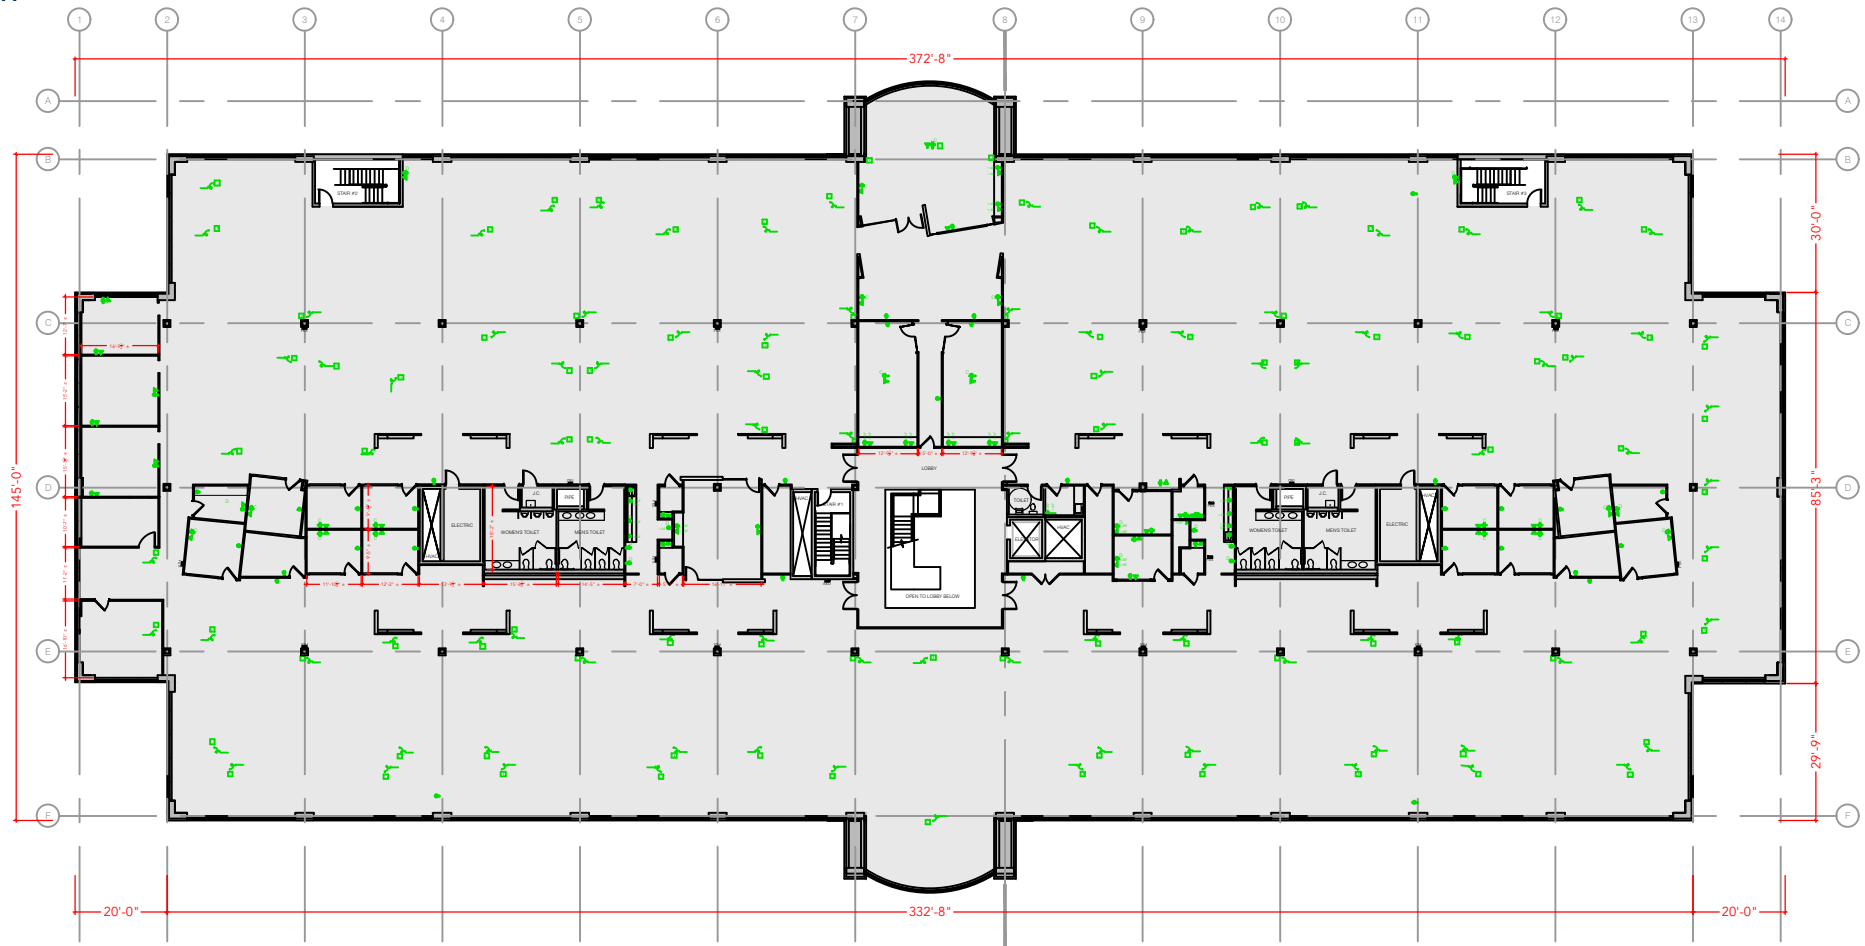

Floor Plan