


TOTAL SF AVAILABLE -29,326 RSF (12%)


OFFICE - 27,137 RSF (12%)

PROP. CIRC.- 2,189 RSF (12%)

[Click to access CADD file](#)

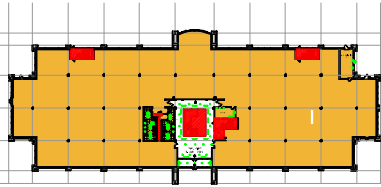

Key Plan

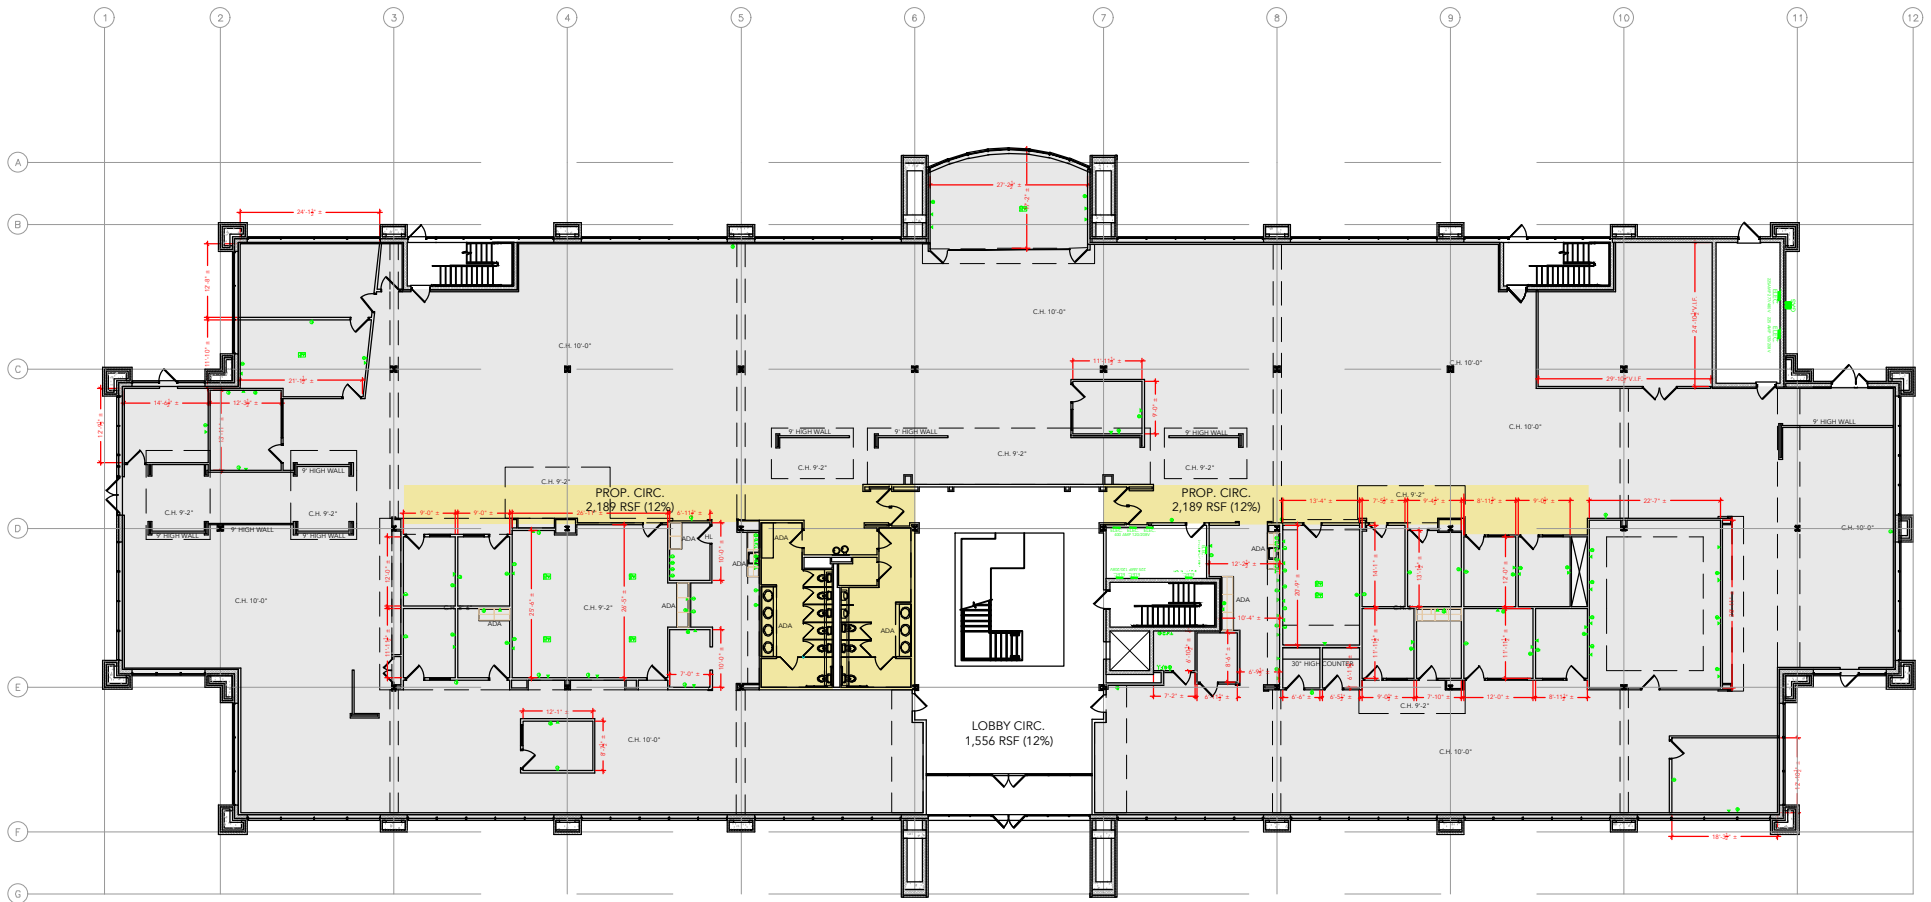

Floor Plan