


TOTAL SF AVAILABLE -32,188 RSF (12%)


OFFICE- 29,704 RSF (12%)

PROP. CIRC.- 2,484 RSF (12%)

[Click to access CADD file](#)

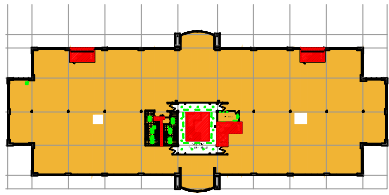

Key Plan

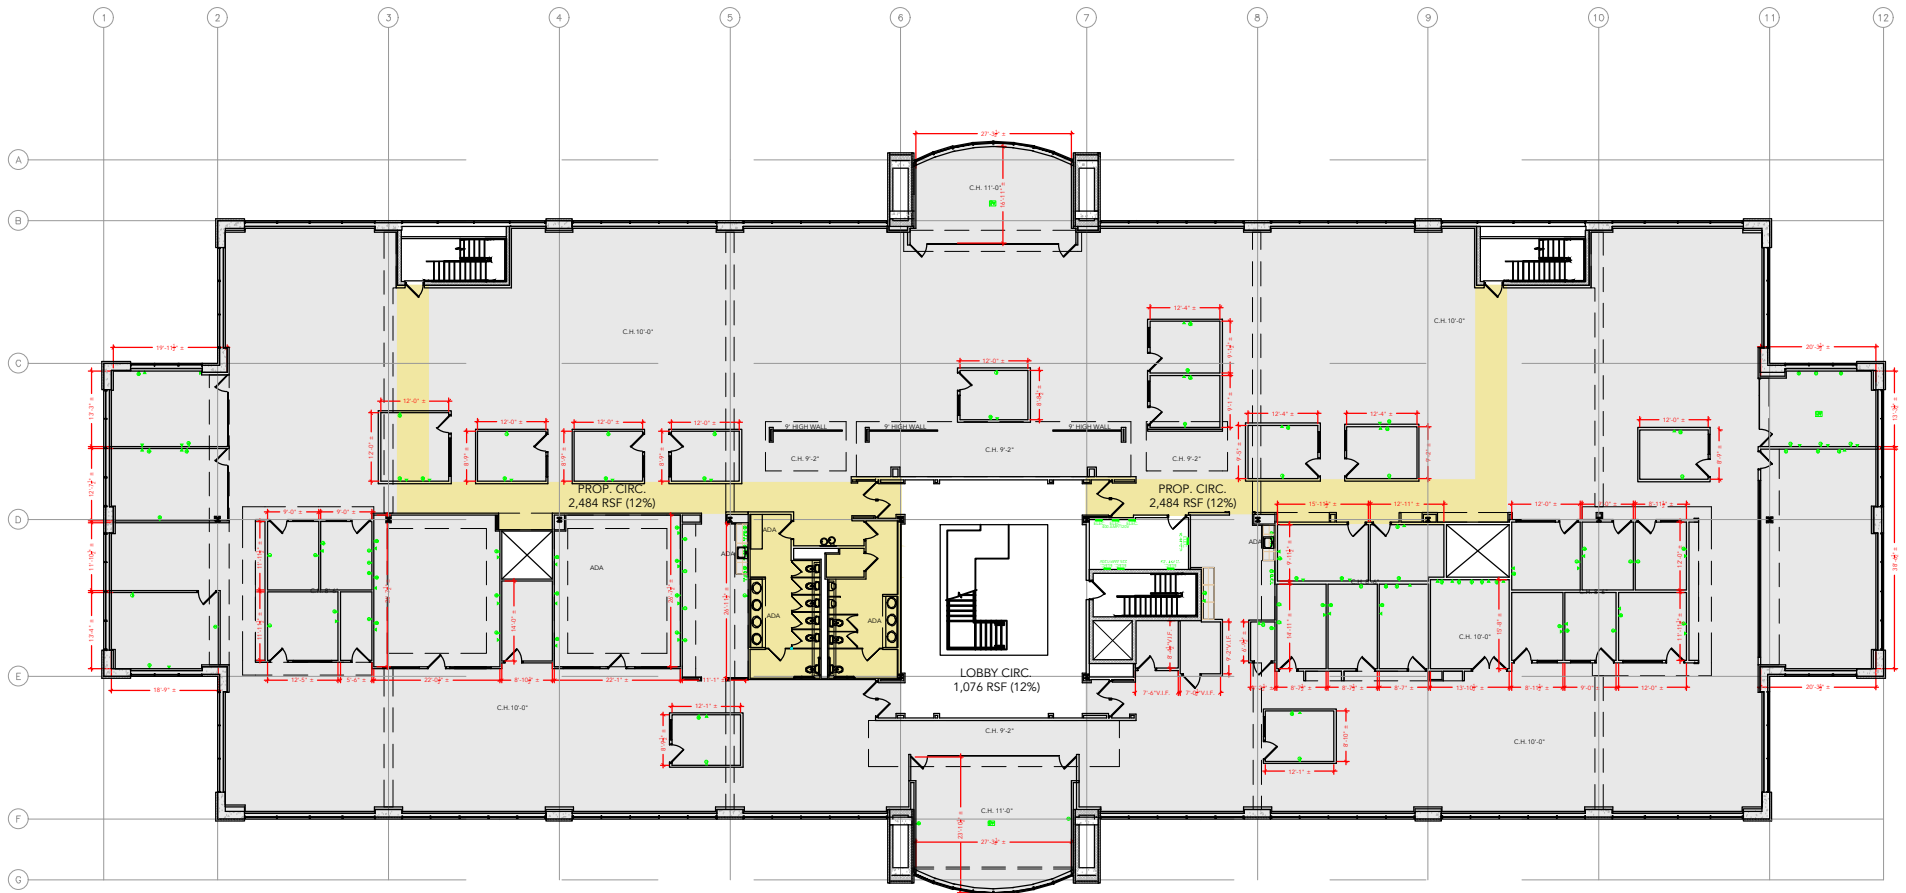

Floor Plan