


**TOTAL SF AVAILABLE - 20,410 SF**


**OFFICE - 0,000 SF**

**WAREHOUSE - 20,410 SF**

[Click to access 3D model](#)

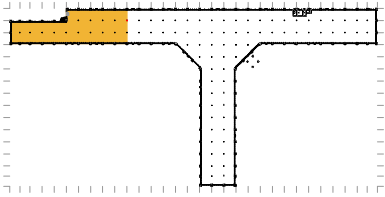

Key Plan

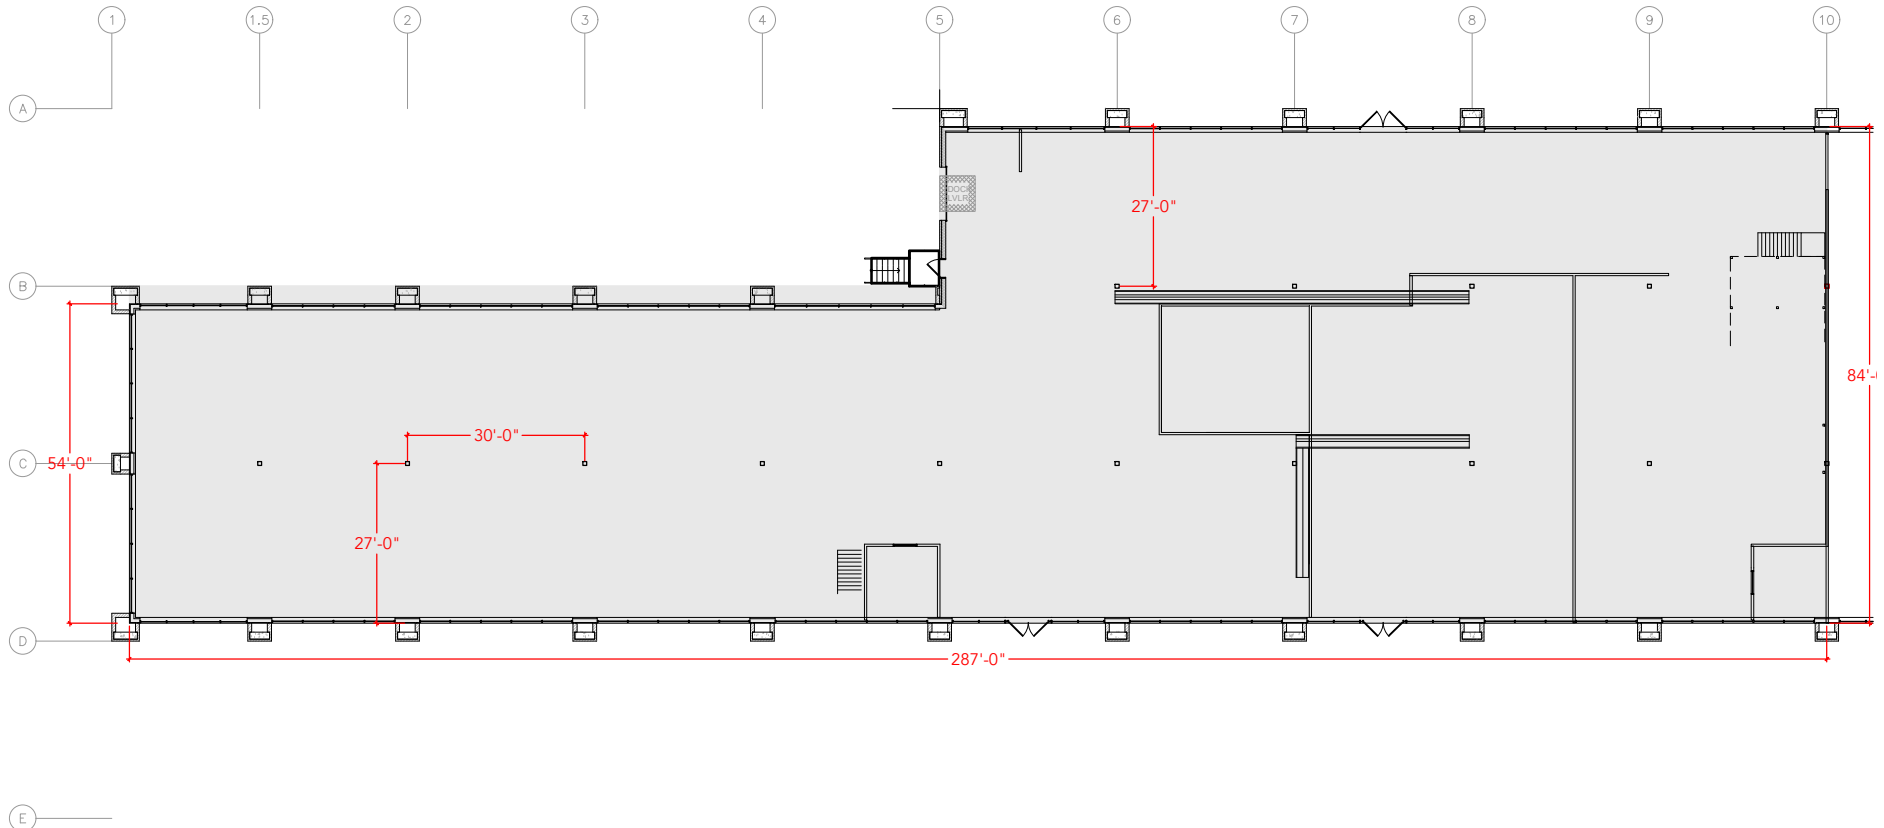

Floor Plan