



TOTAL SF AVAILABLE - 20,410 SF

OFFICE - 0,000 SF
WAREHOUSE - 20,410 SF

[Click to access 3D model](#)

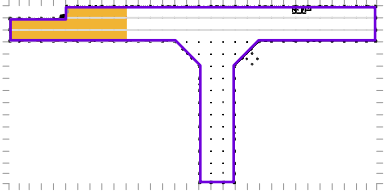

Key Plan

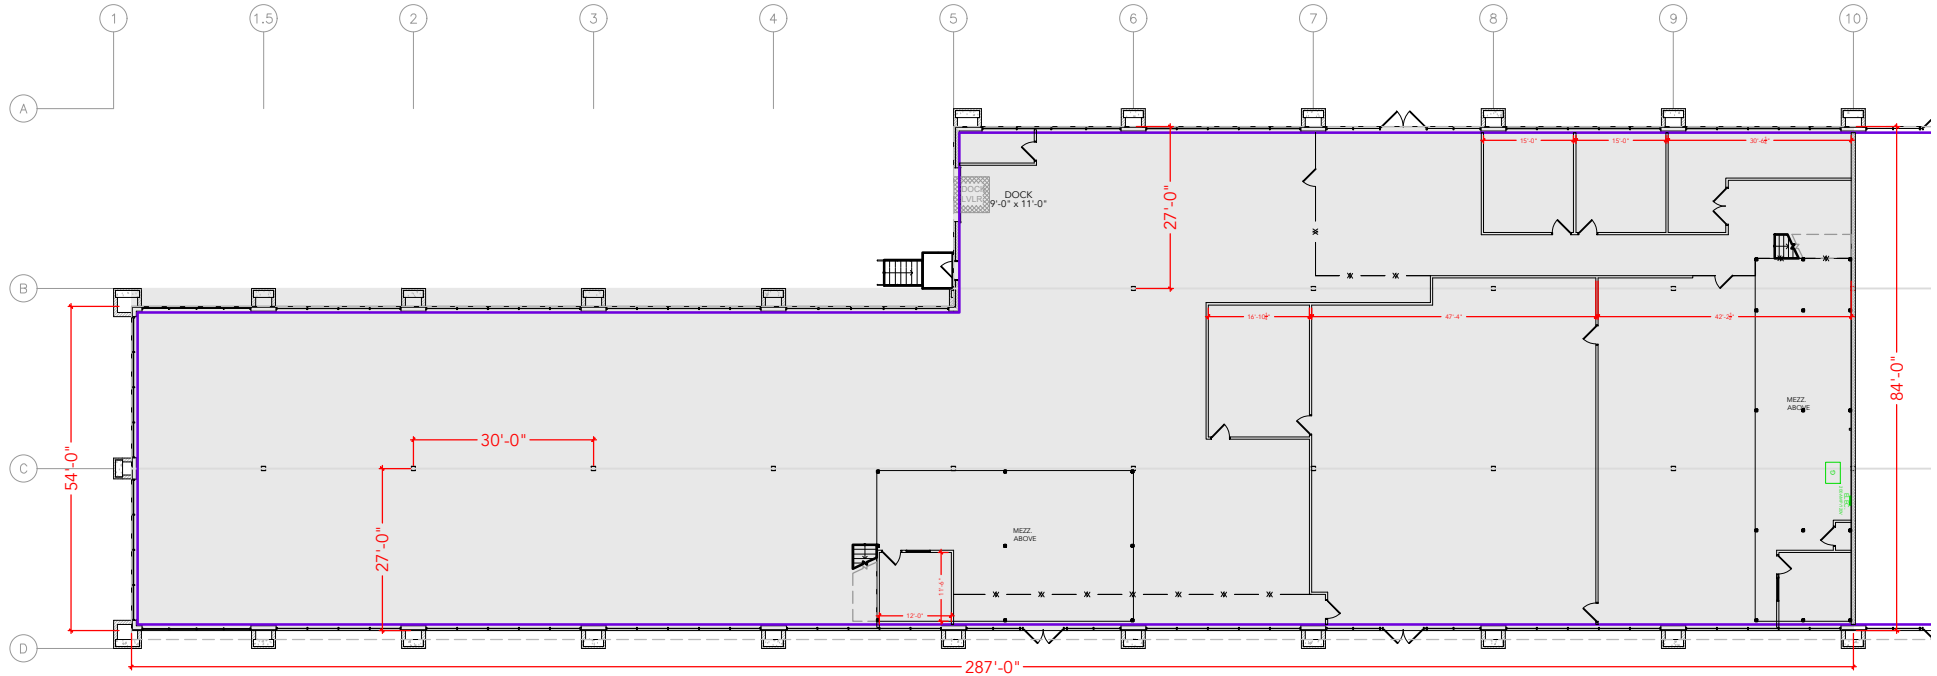

Floor Plan