


TOTAL SF AVAILABLE - 10,225 SF


OFFICE - 10,225 SF

WAREHOUSE - 0,000 SF

[Click to access CADD file](#)

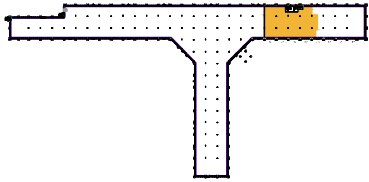

Key Plan

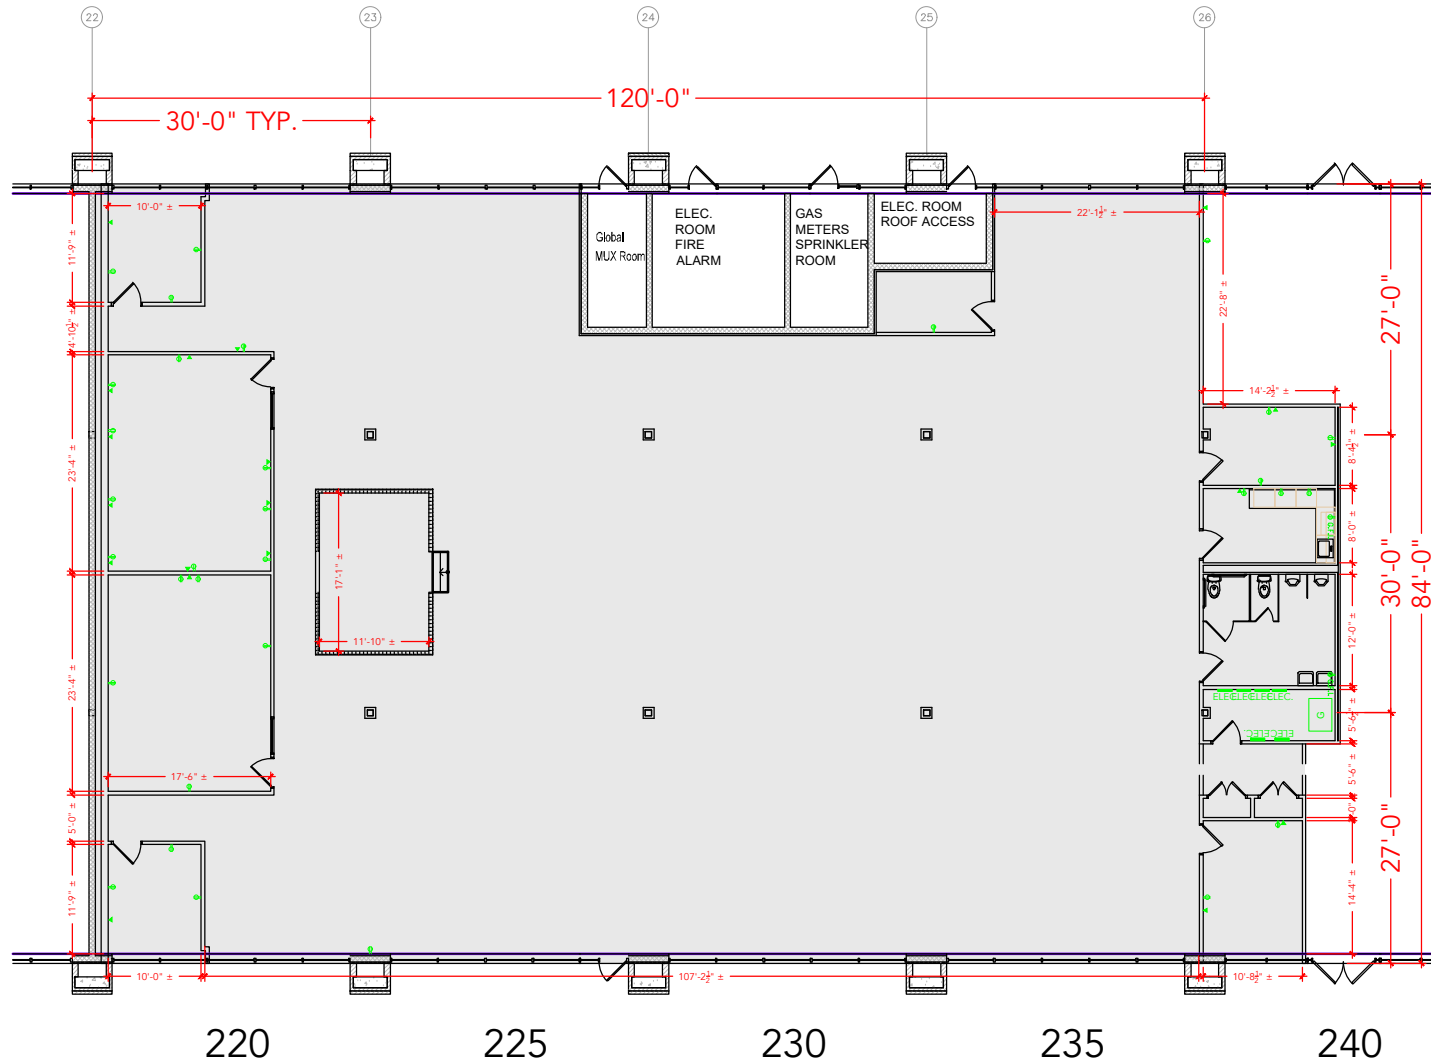

Floor Plan