


TOTAL SF AVAILABLE - 21,089 SF

OFFICE - 21,089 SF
WAREHOUSE - 0,000 SF

[Click to access 3D model](#)



Key Plan

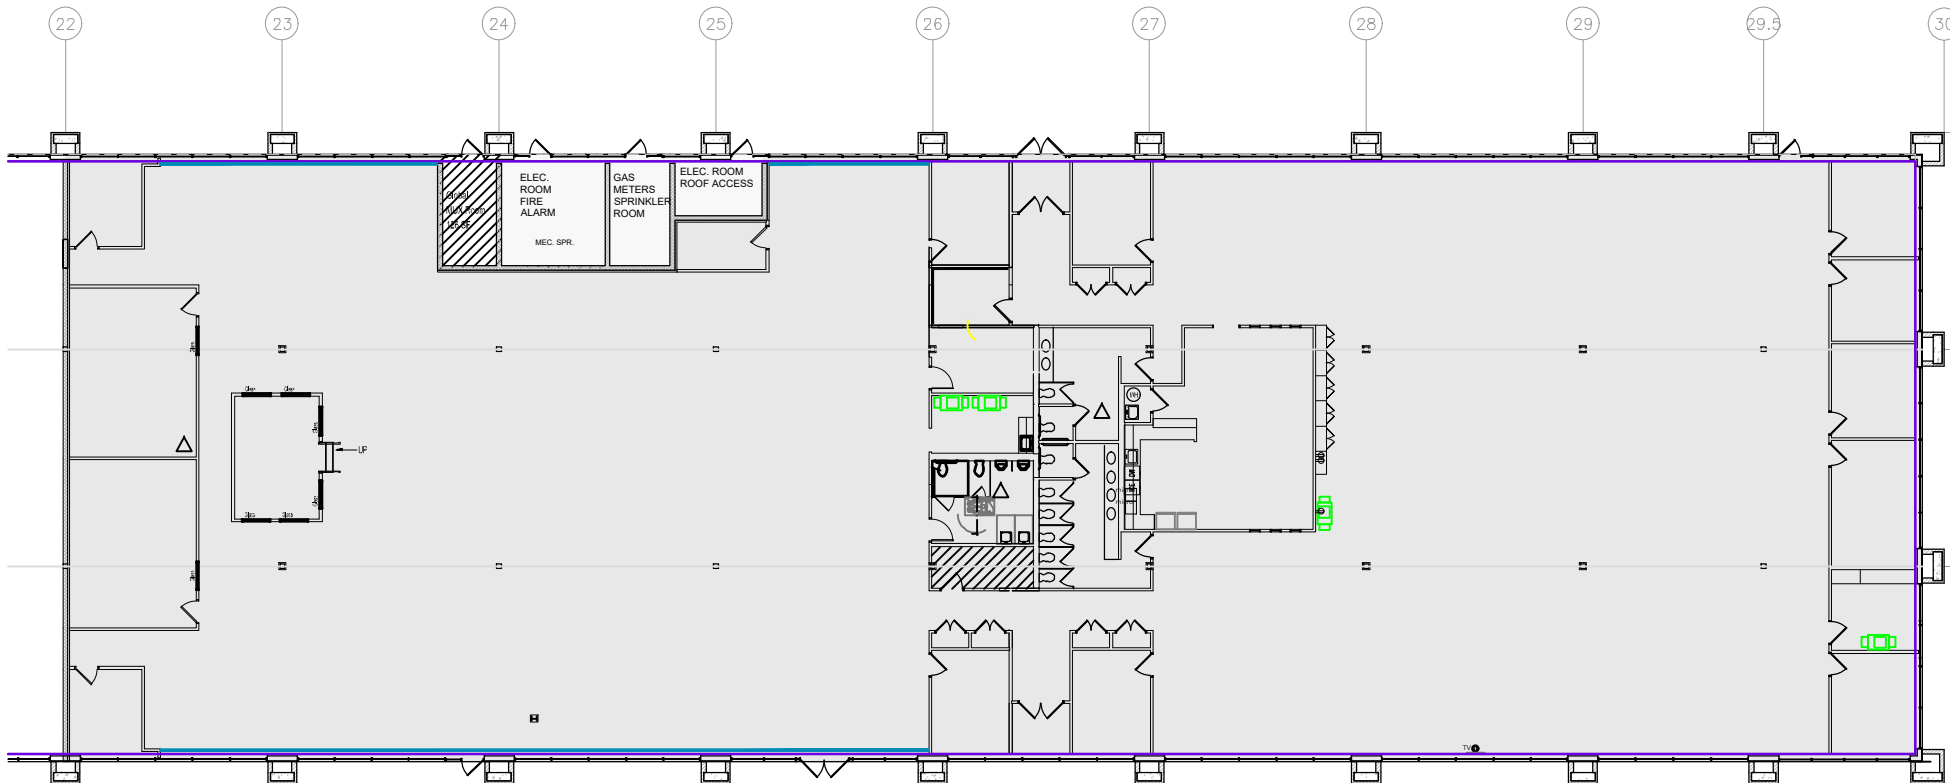

Floor Plan