


TOTAL SF AVAILABLE - 2,100 SF

OFFICE - 2,100 SF

WAREHOUSE SF - 0,000 SF

[Click to access 3D model](#)

Key Plan

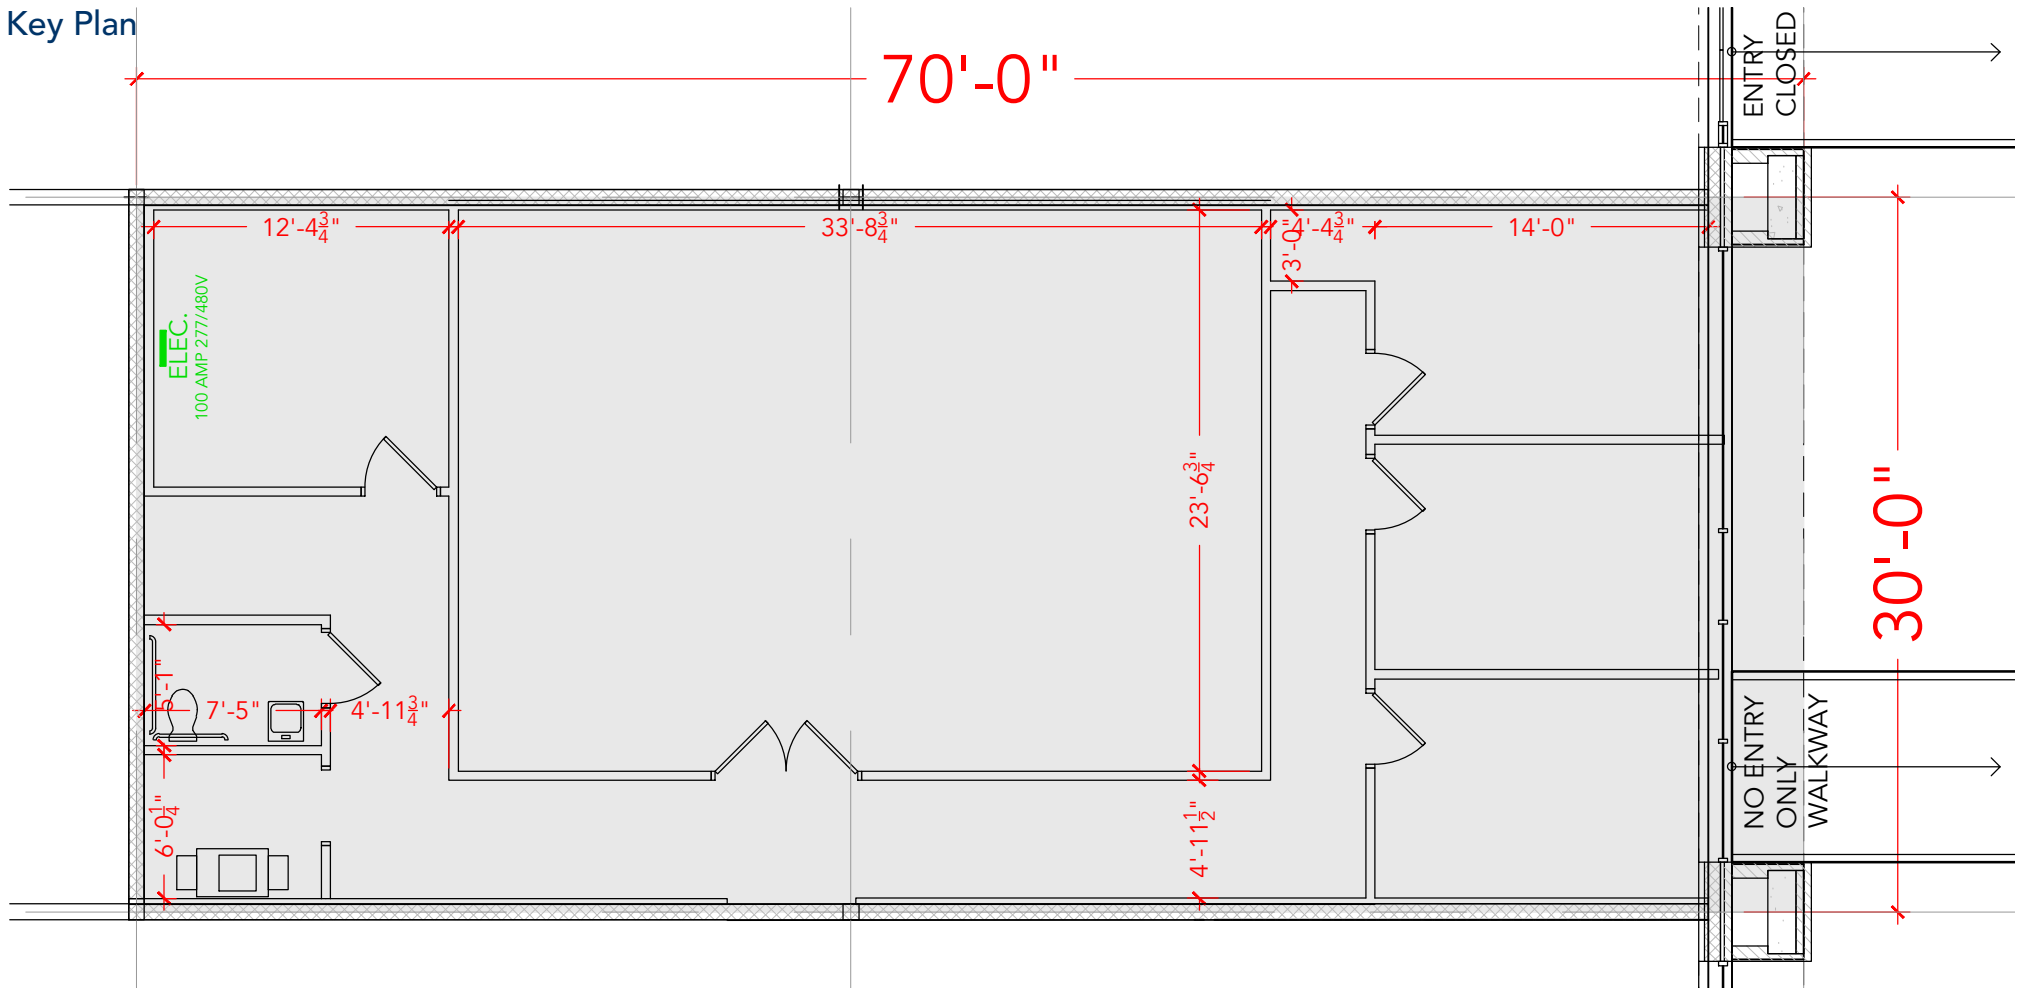

Floor Plan