


TOTAL SF AVAILABLE - 4,110 SF


OFFICE - 1,214 SF

WAREHOUSE - 2,896 SF

[Click to access 3D model](#)

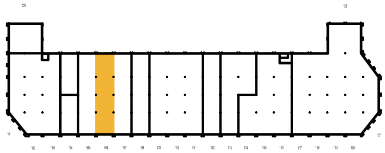

Key Plan

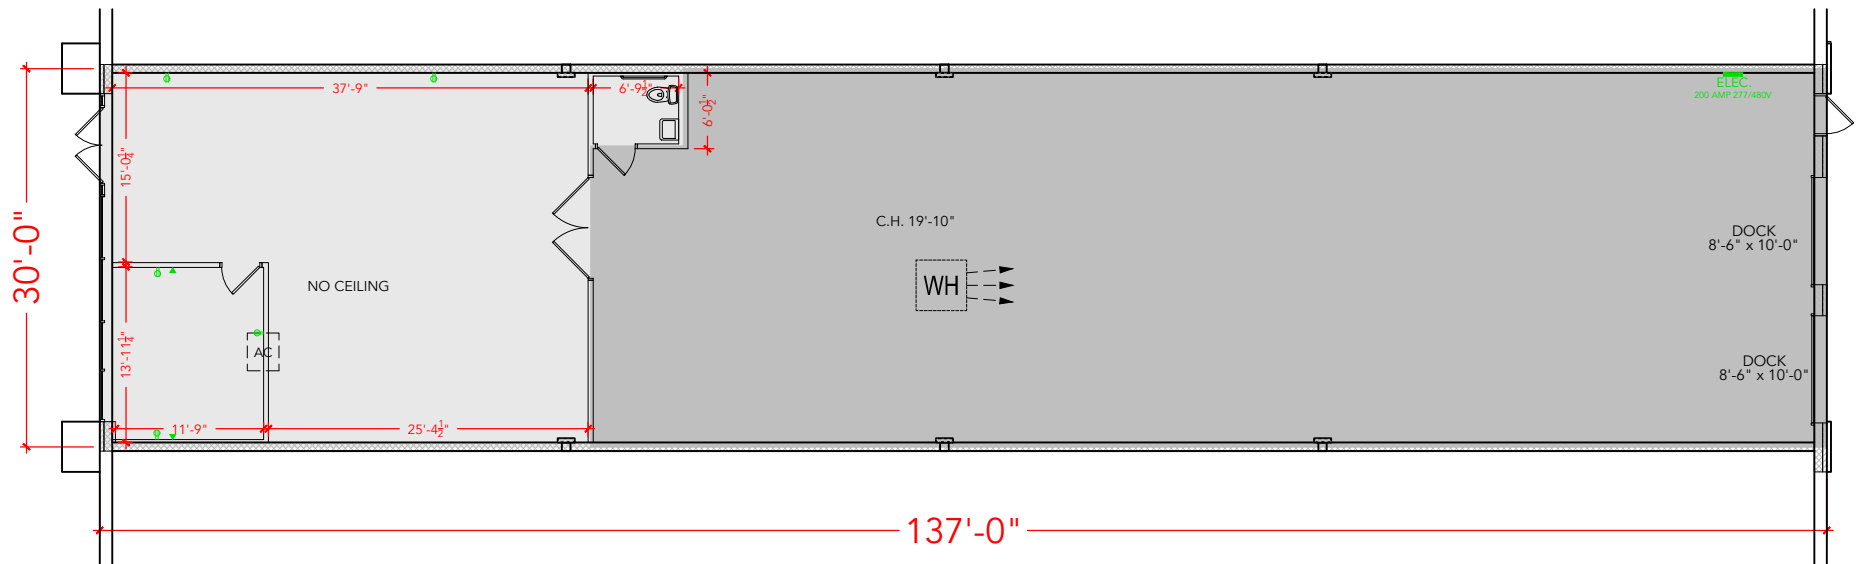

Floor Plan