


TOTAL SF AVAILABLE - 4,200 SF


OFFICE - 234 SF

WAREHOUSE - 3,966 SF

[Click to access 3D model](#)

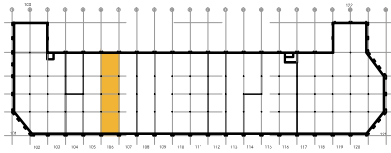

Key Plan

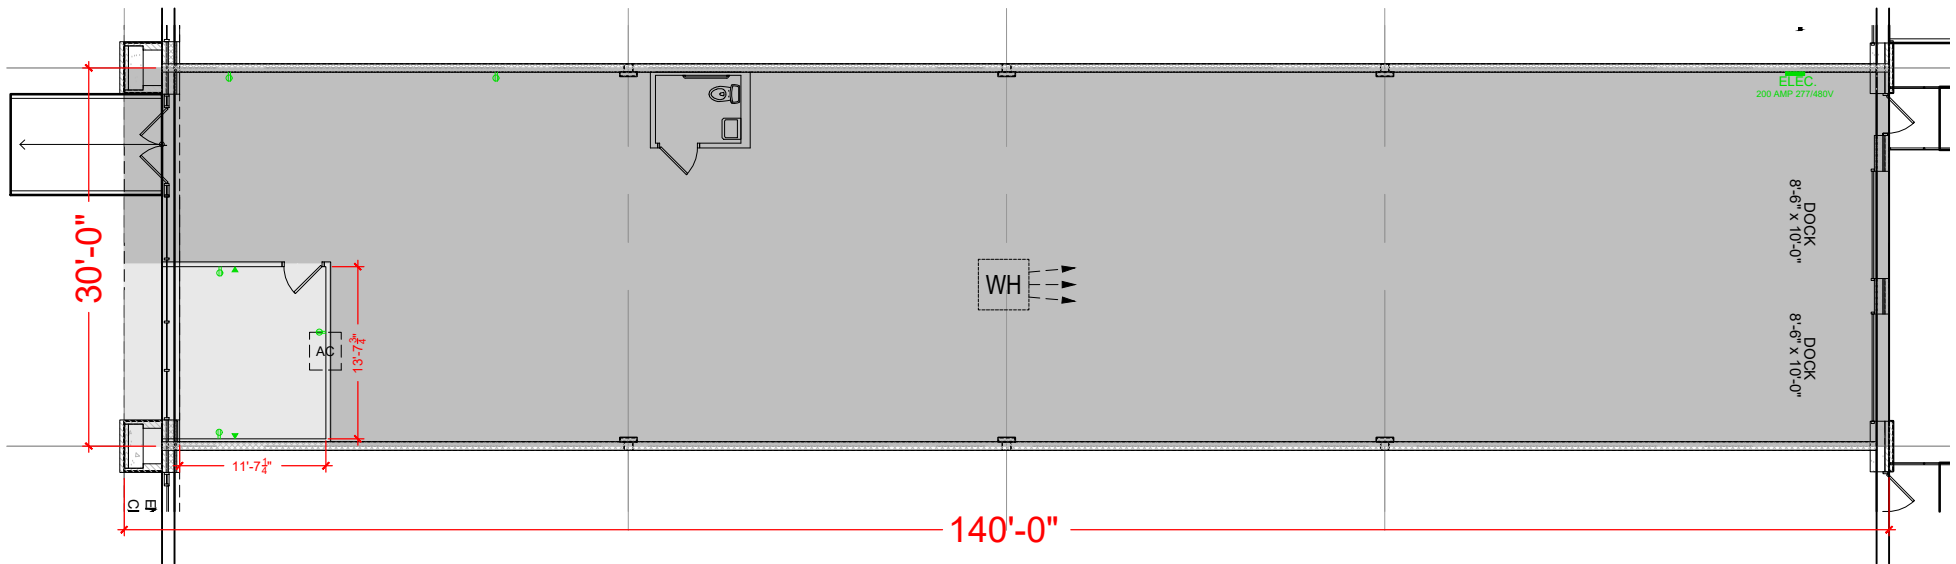

Floor Plan