


TOTAL SF AVAILABLE -6,300 SF


OFFICE - 4,332 SF

WAREHOUSE - 1,968 SF

[Click to access 3D model](#)

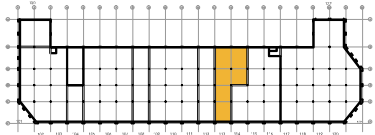

Key Plan

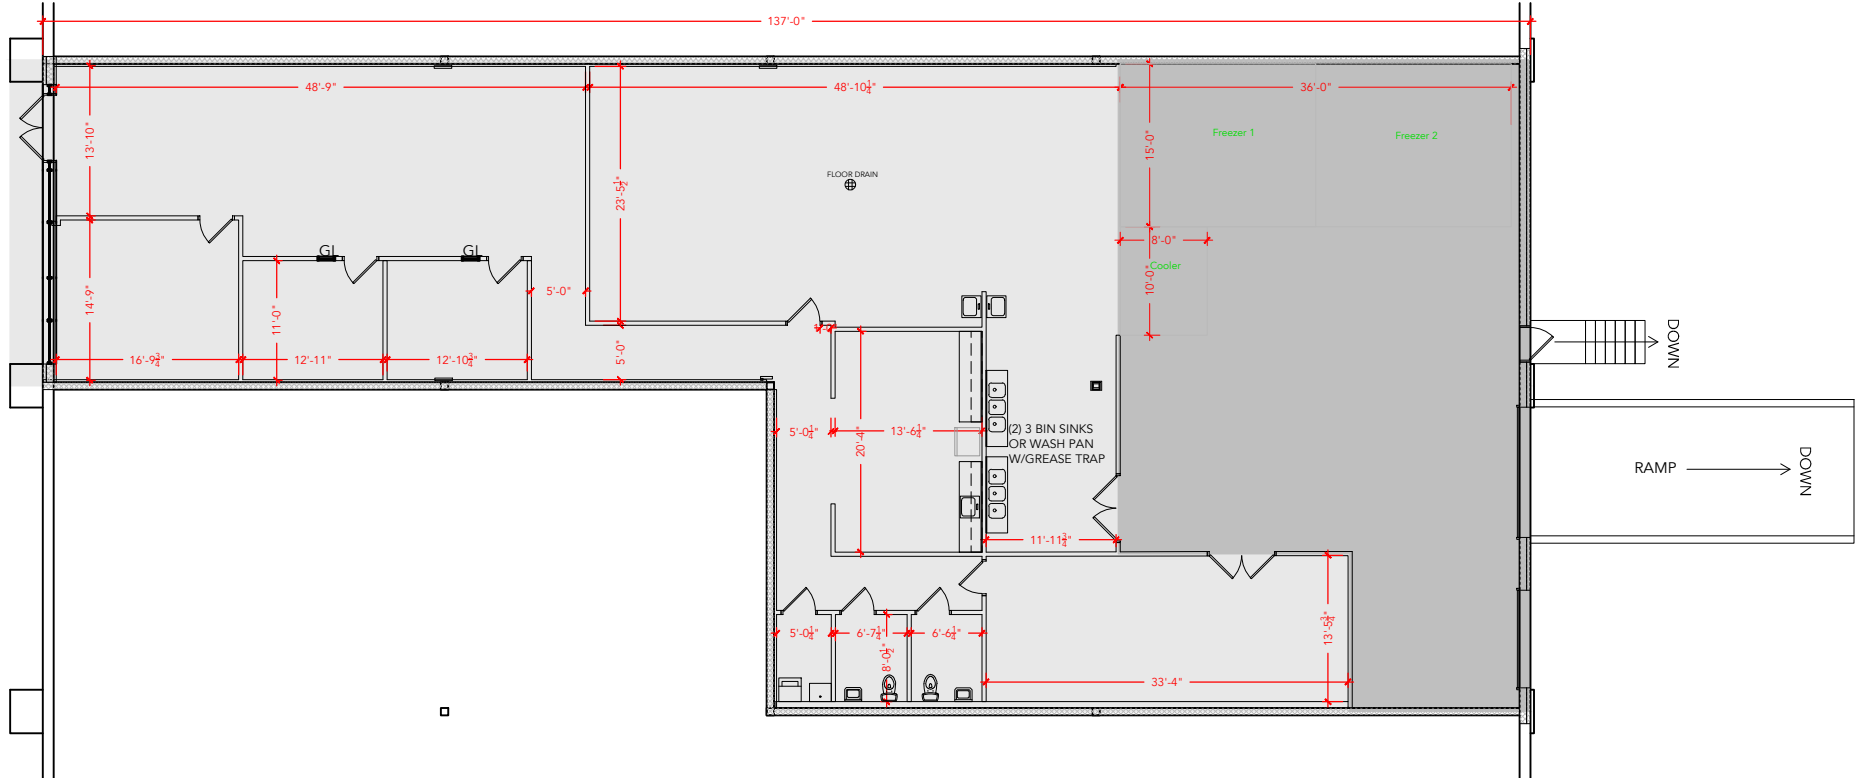

Floor Plan