


TOTAL SF AVAILABLE -6,300 SF


OFFICE - 4,691 SF

WAREHOUSE - 1,609 SF

[Click to access 3D model](#)

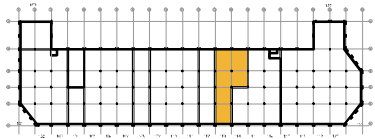

Key Plan

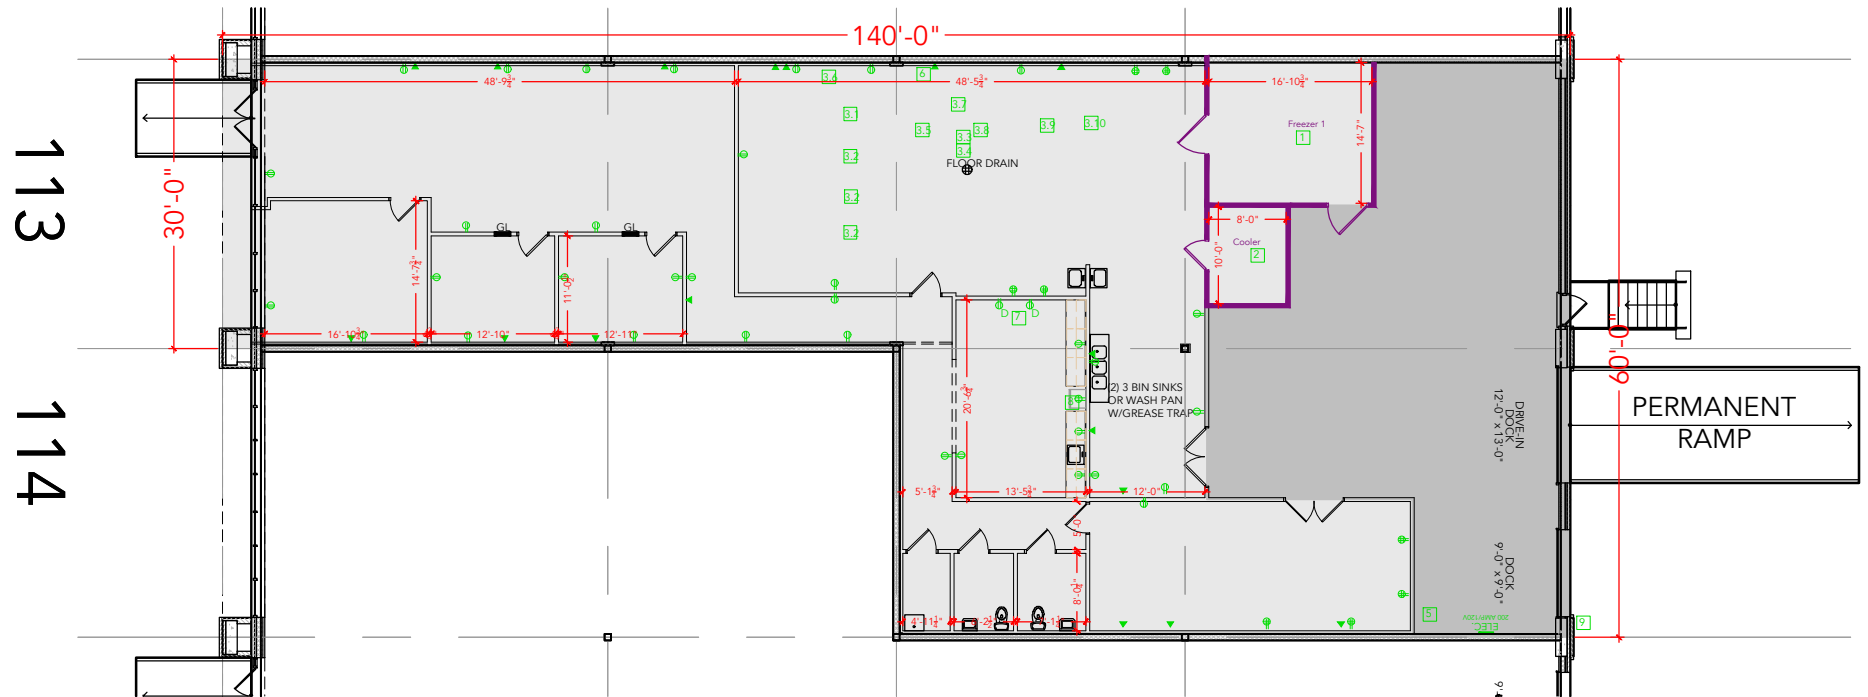

Floor Plan