


**TOTAL SF AVAILABLE - 13,496 SF**


OFFICE - 13,496 SF

WAREHOUSE SF - 0,000 SF

[Click to access 3D model](#)

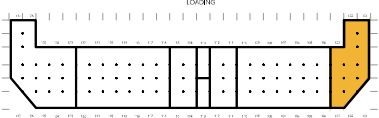

Key Plan

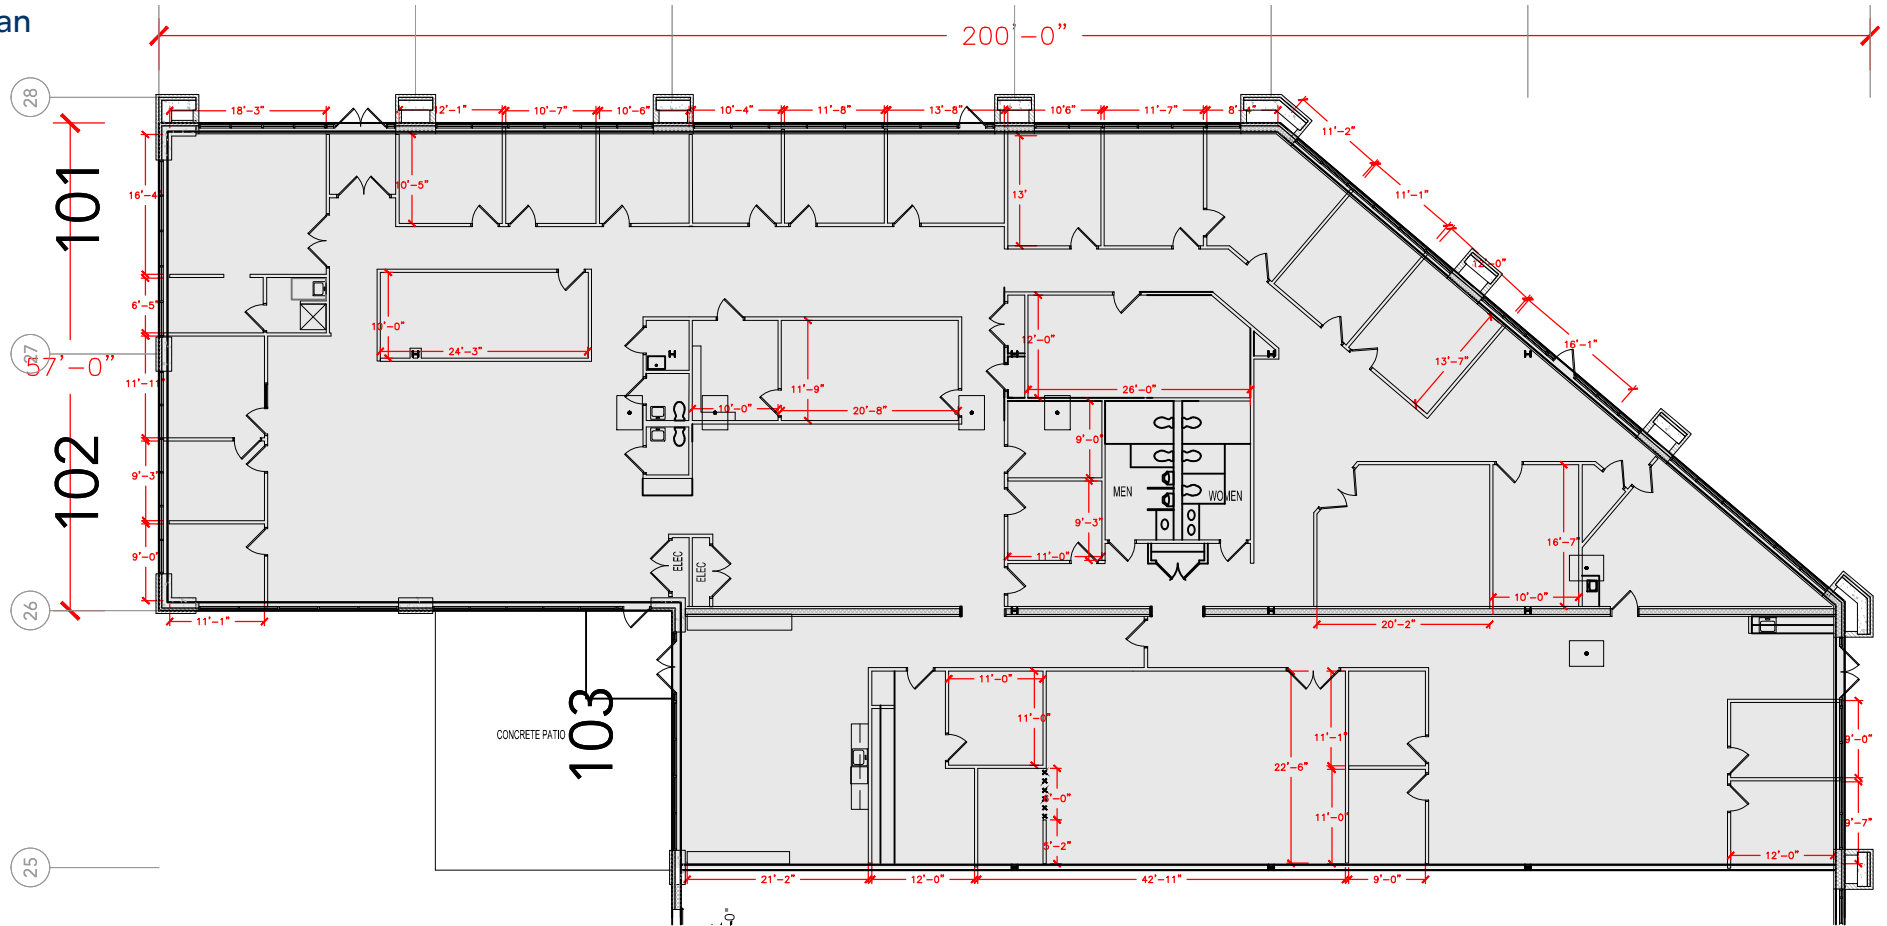

Floor Plan