


**TOTAL SF AVAILABLE - 8,072 SF**


**OFFICE - 5,537 SF**

**WAREHOUSE - 2,536 SF**

[Click to access 3D model](#)

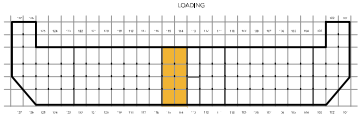

Key Plan

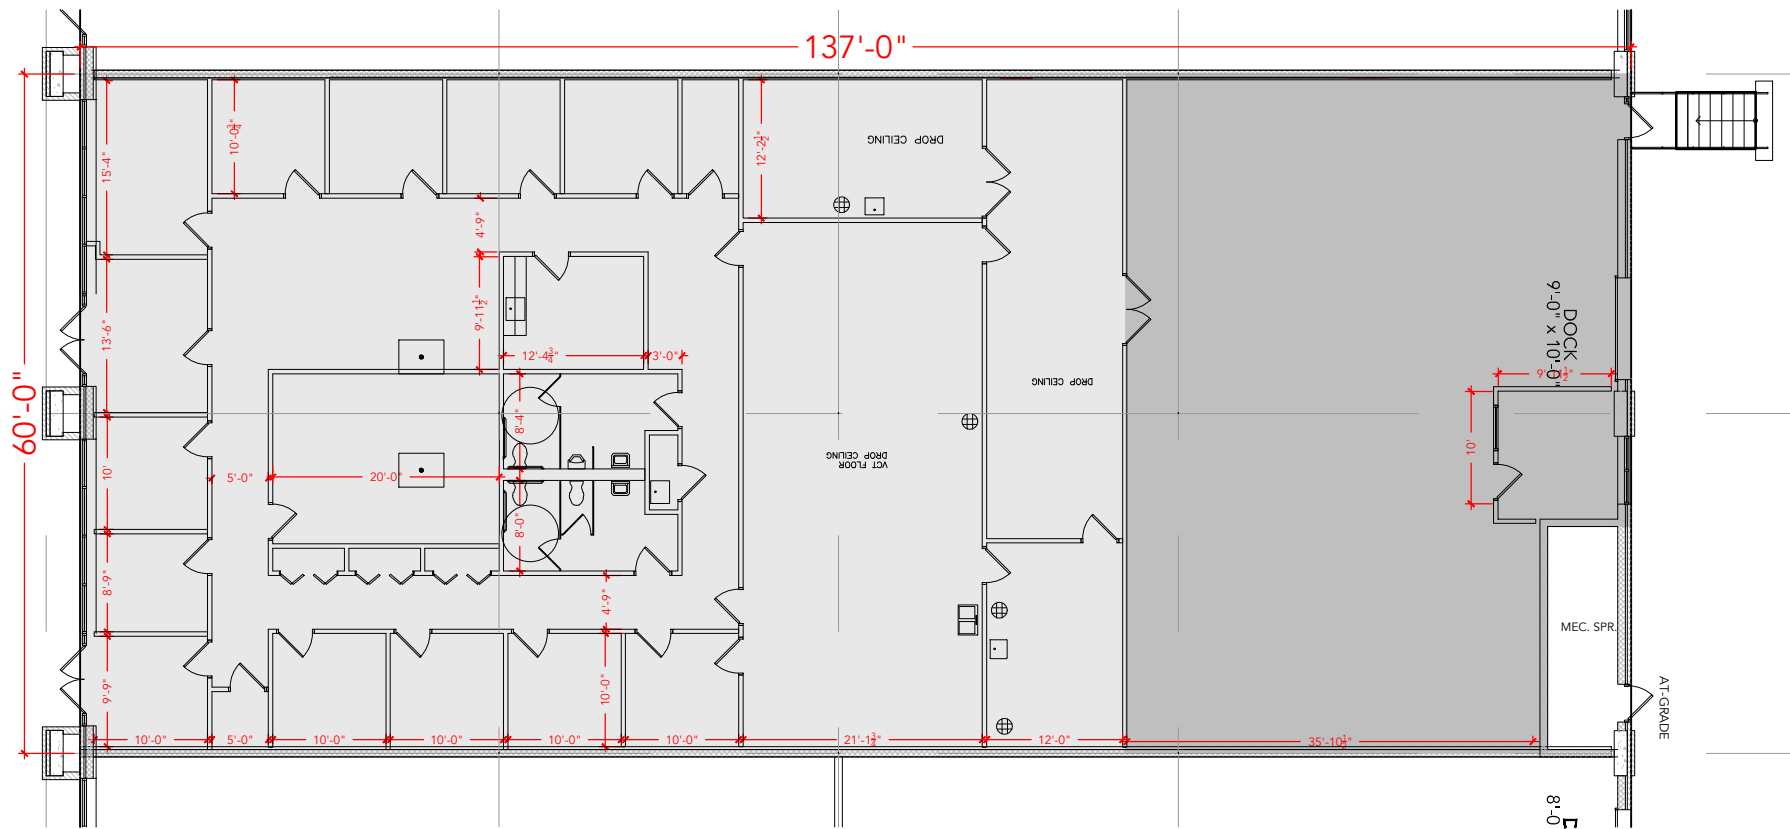

Floor Plan