


TOTAL SF AVAILABLE - 50,217 SF

OFFICE - 32,475 SF

WAREHOUSE - 17,742 SF

[Click to access 3D model](#)

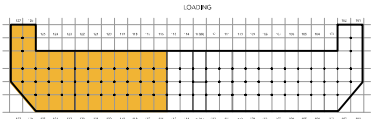

Key Plan



Floor Plan