

TOTAL SF AVAILABLE - 7,830 SF


OFFICE - 365 SF

WAREHOUSE - 7,465 SF

[Click to access 3D model](#)



Key Plan

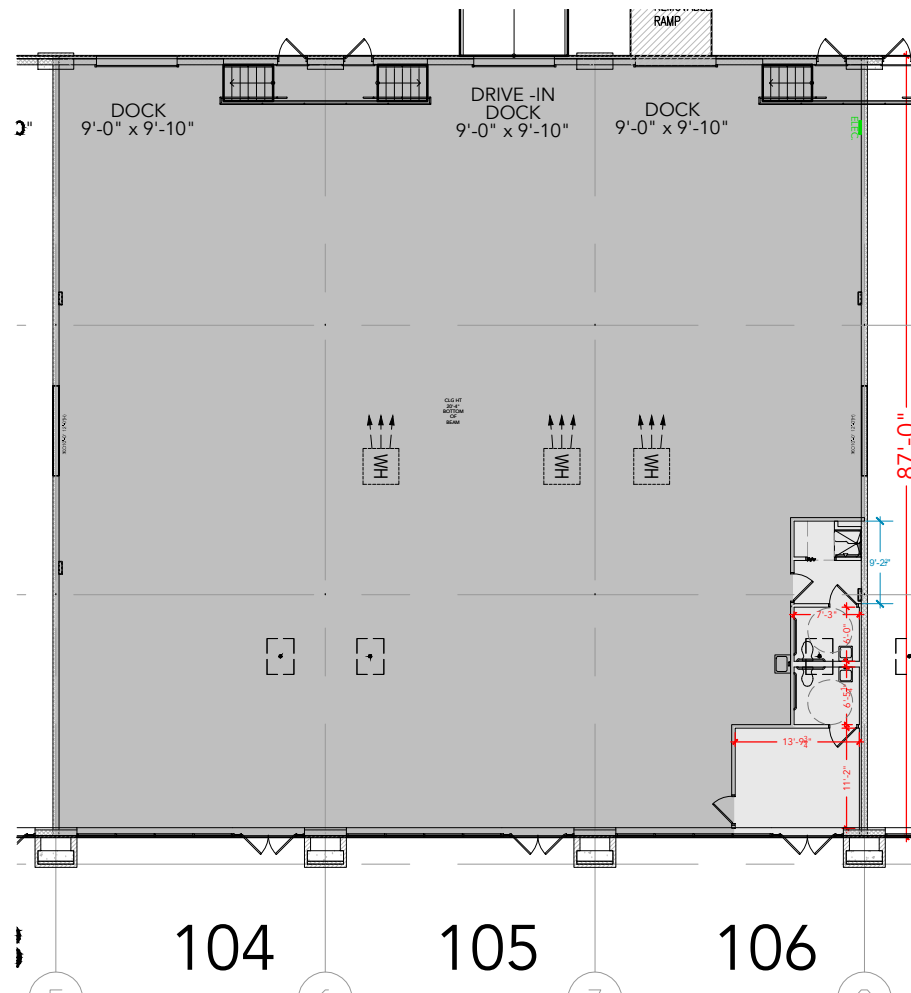

Floor Plan