


TOTAL SF AVAILABLE -10,277 RSF

OFFICE - 10,277 RSF


WAREHOUSE - 0,000 RSF

* INCLUDES % OF METER ROOM

[Click to access CADD file](#)

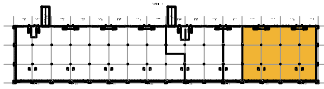

Key Plan

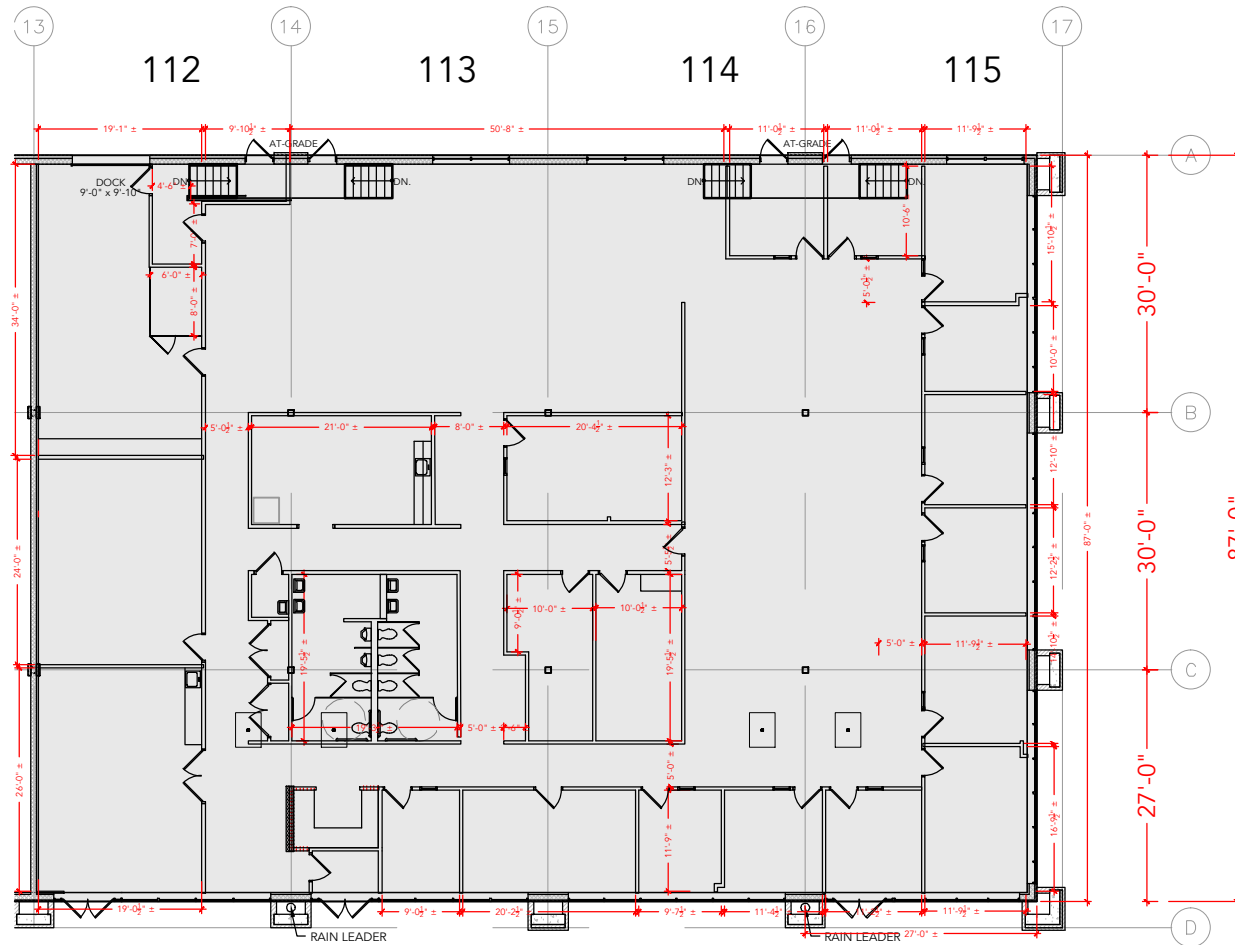

Floor Plan