


**TOTAL SF AVAILABLE -3,600 SF**


OFFICE - 2,230 SF

WAREHOUSE SF - 1,370 SF

[Click to access 3D model](#)

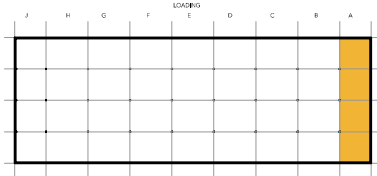

Key Plan

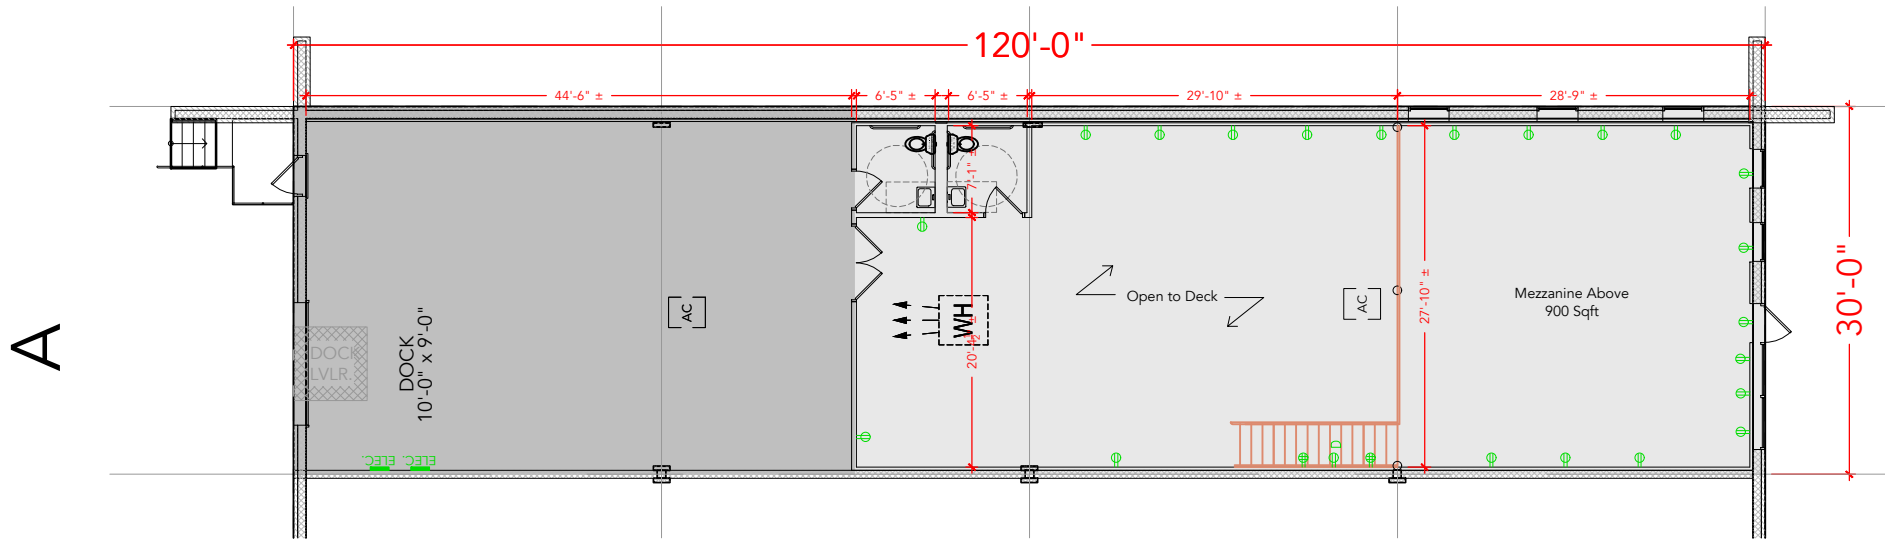

## Floor Plan