



**TOTAL SF AVAILABLE - 4,800 SF**

OFFICE - 0,000 SF  
WAREHOUSE SF - 4,800 SF

[Click to access 3D model](#)

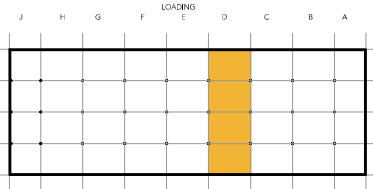

Key Plan

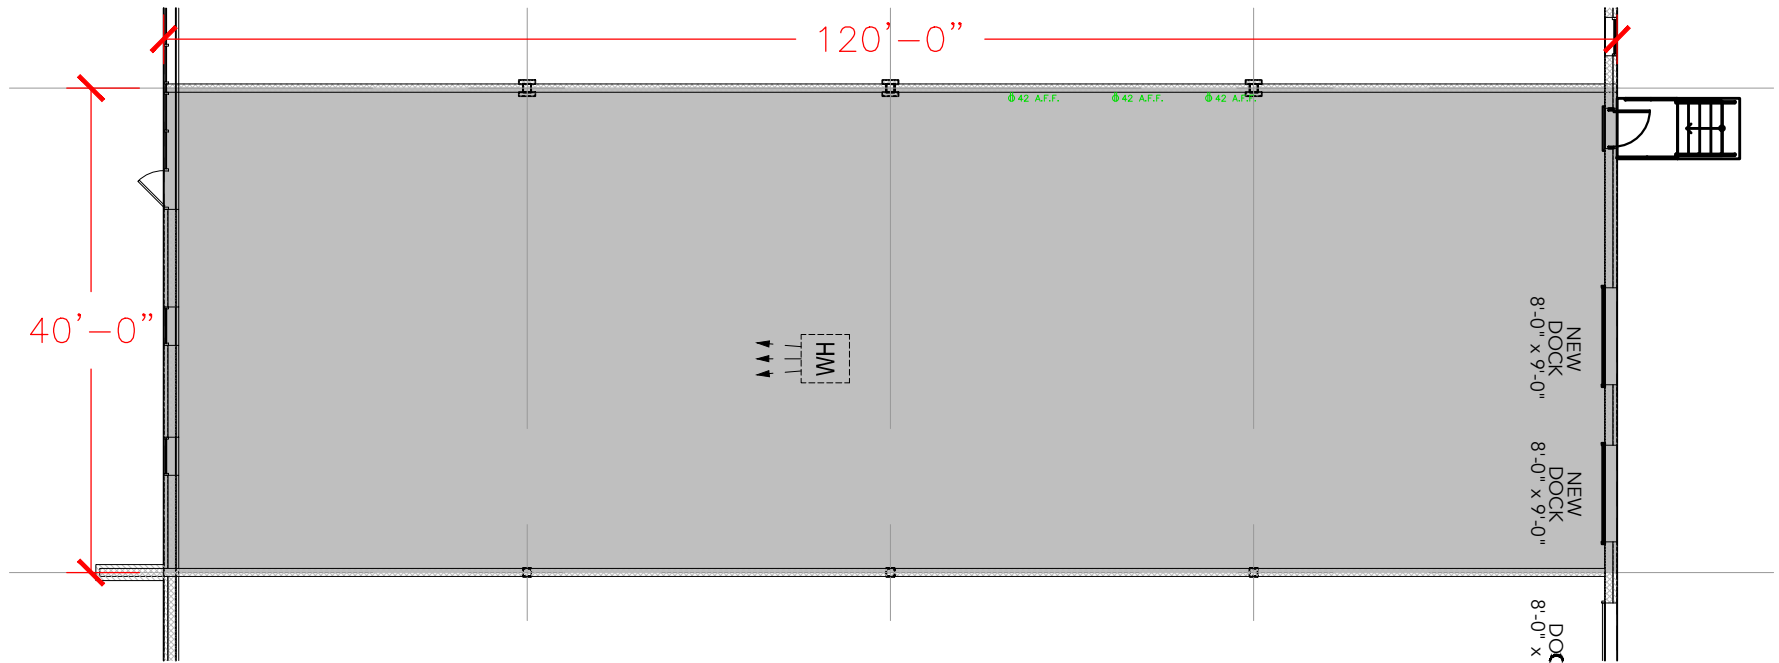

## Floor Plan