


**TOTAL SF AVAILABLE -2,121 RSF**


OFFICE - 335 RSF

WAREHOUSE - 1,786 RSF

[Click to access CADD file](#)

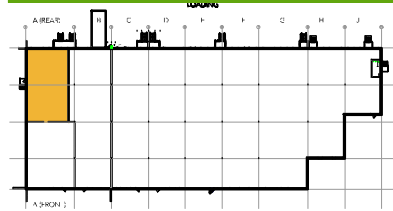

Key Plan

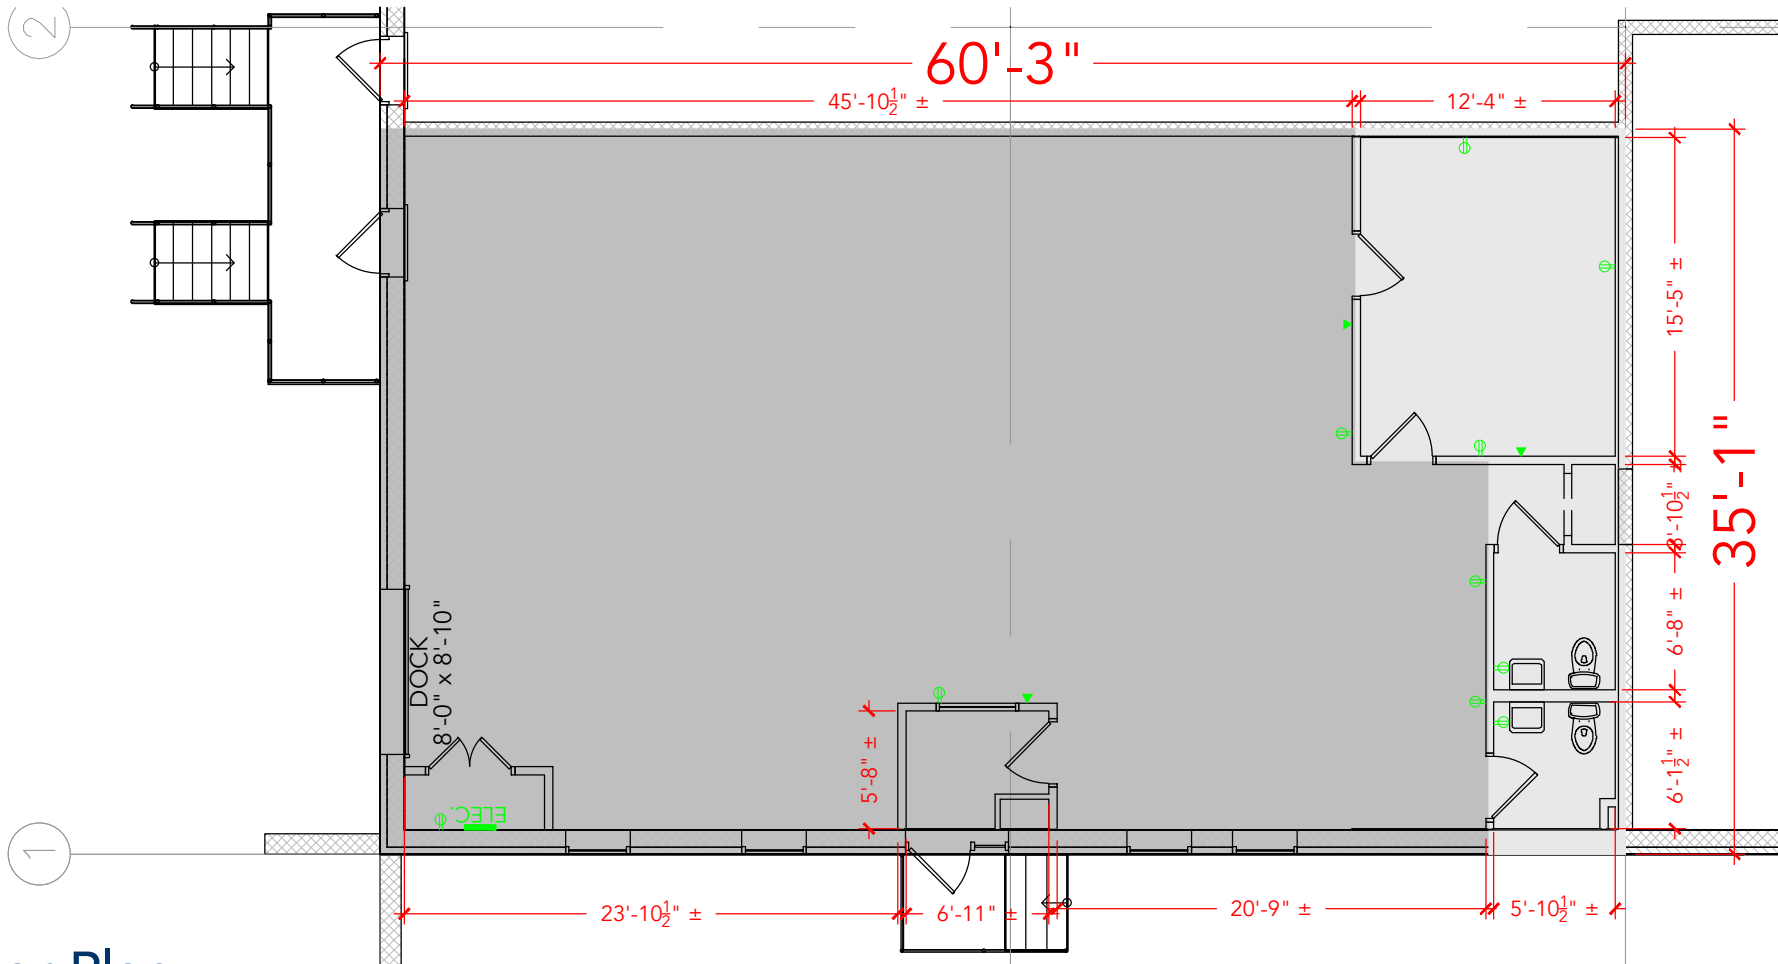

Floor Plan