


**TOTAL SF AVAILABLE -3,759 RSF**


OFFICE - 1,226 RSF  
WAREHOUSE - 2,533 RSF

\* INCLUDES % OF METER ROOM

[Click to access CADD file](#)

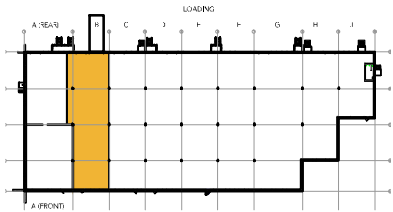

Key Plan

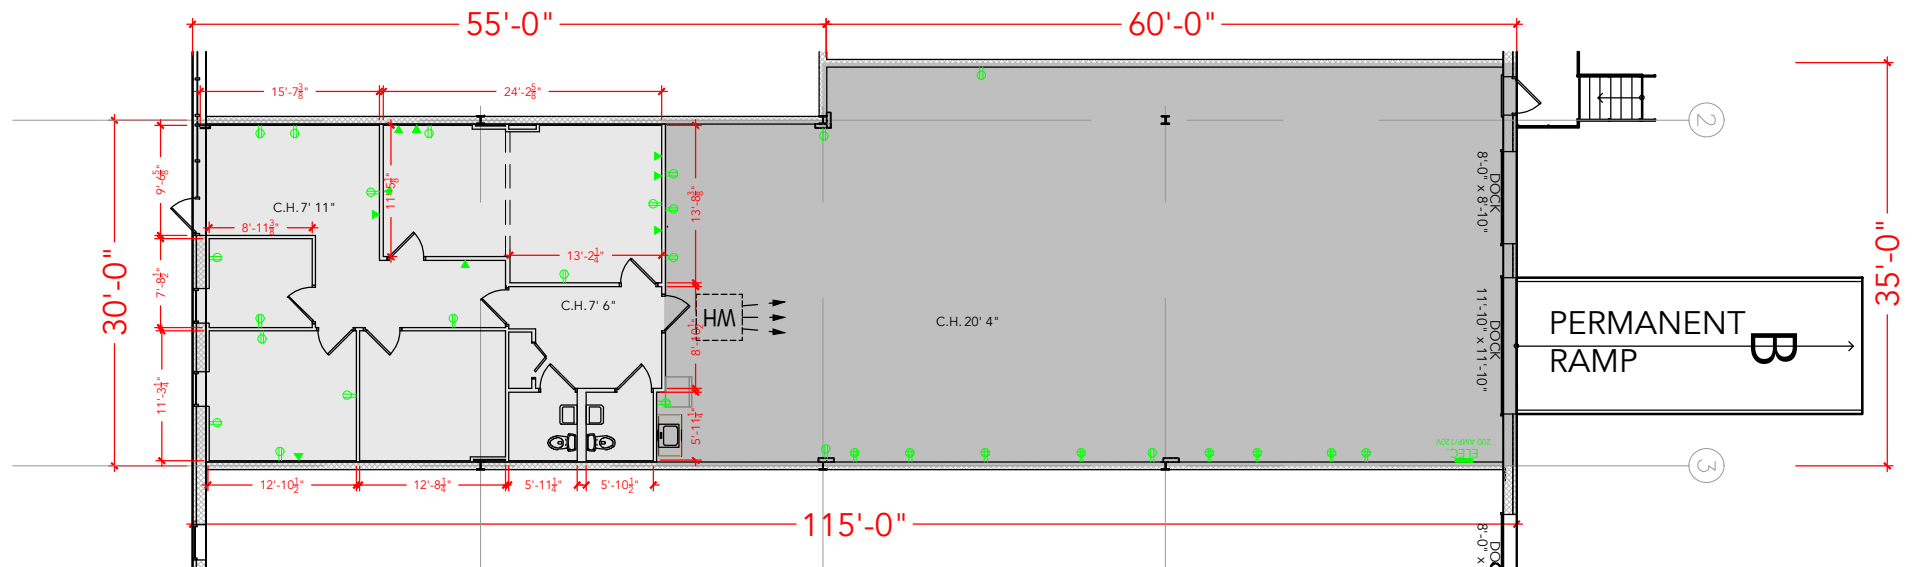

## Floor Plan