


**TOTAL SF AVAILABLE -3,462 RSF**

OFFICE - 2,236 RSF


WAREHOUSE - 1,226 RSF

\* INCLUDES % OF METER ROOM

[Click to access CADD file](#)

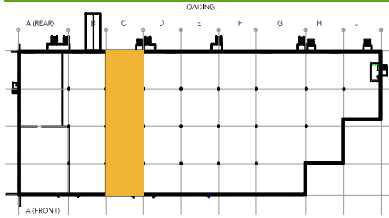

Key Plan

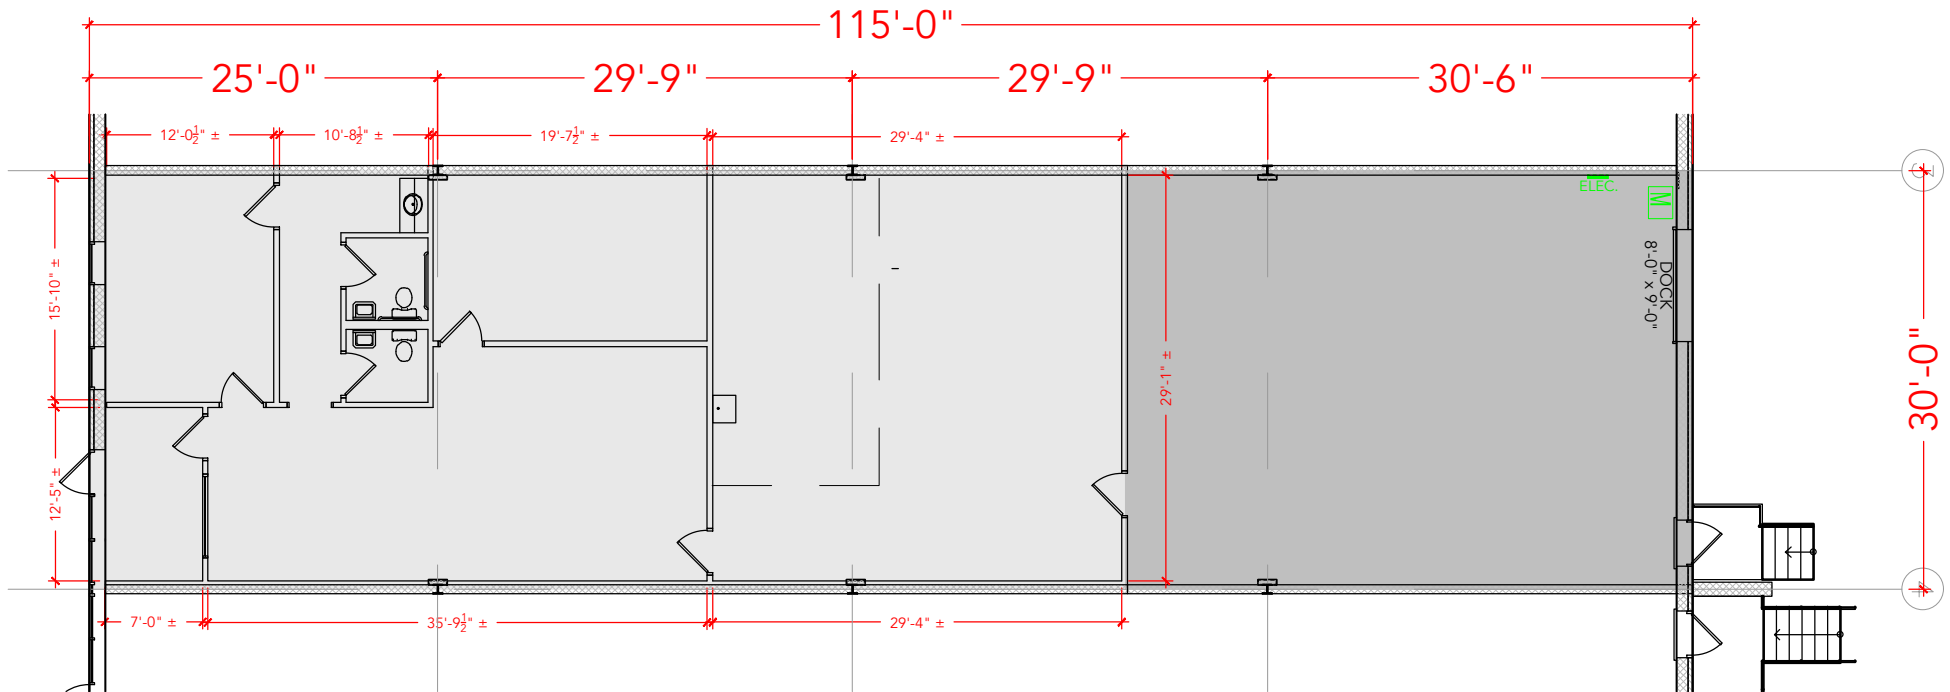

## Floor Plan