


TOTAL SF AVAILABLE -3,462 RSF

OFFICE - 2,242 RSF


WAREHOUSE - 1,220 RSF

* INCLUDES % OF METER ROOM

[Click to access CADD file](#)

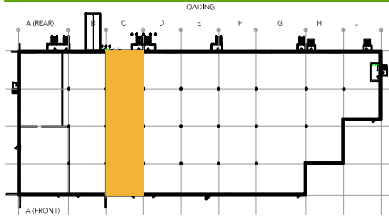

Key Plan

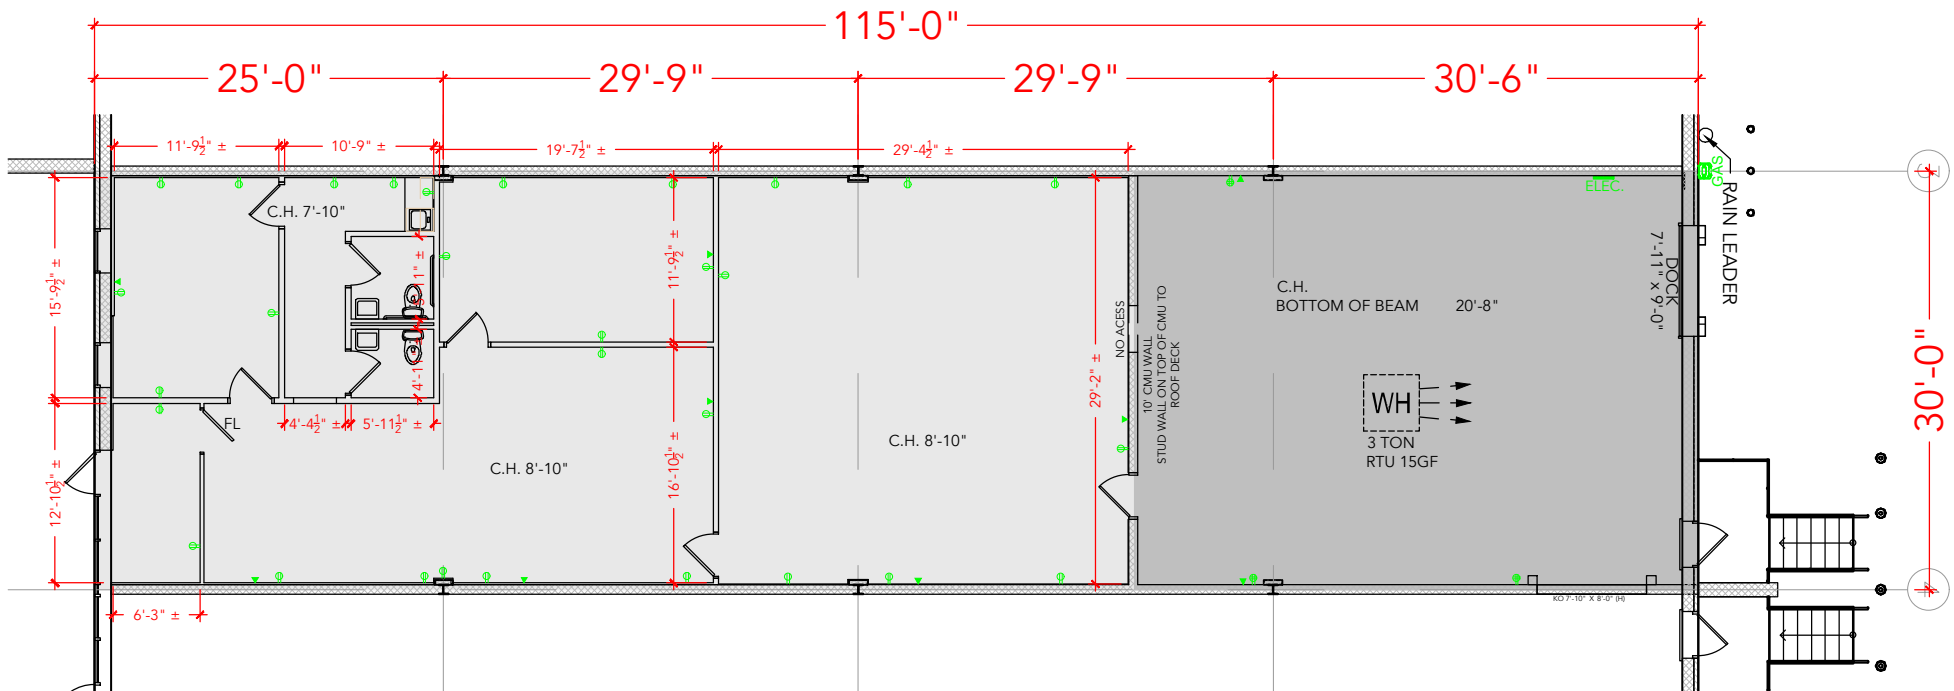

Floor Plan