


# HAMMONDS NORTH

823 HAMMONDS FERRY RD  
SUITE H-J  
LINTHICUM, MD 21090


## Building Key Plan

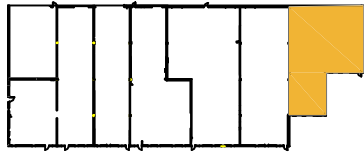

TOTAL SF AVAILABLE - 4,350 SF

OFFICE - 3,690 SF

WAREHOUSE SF - 660 SF

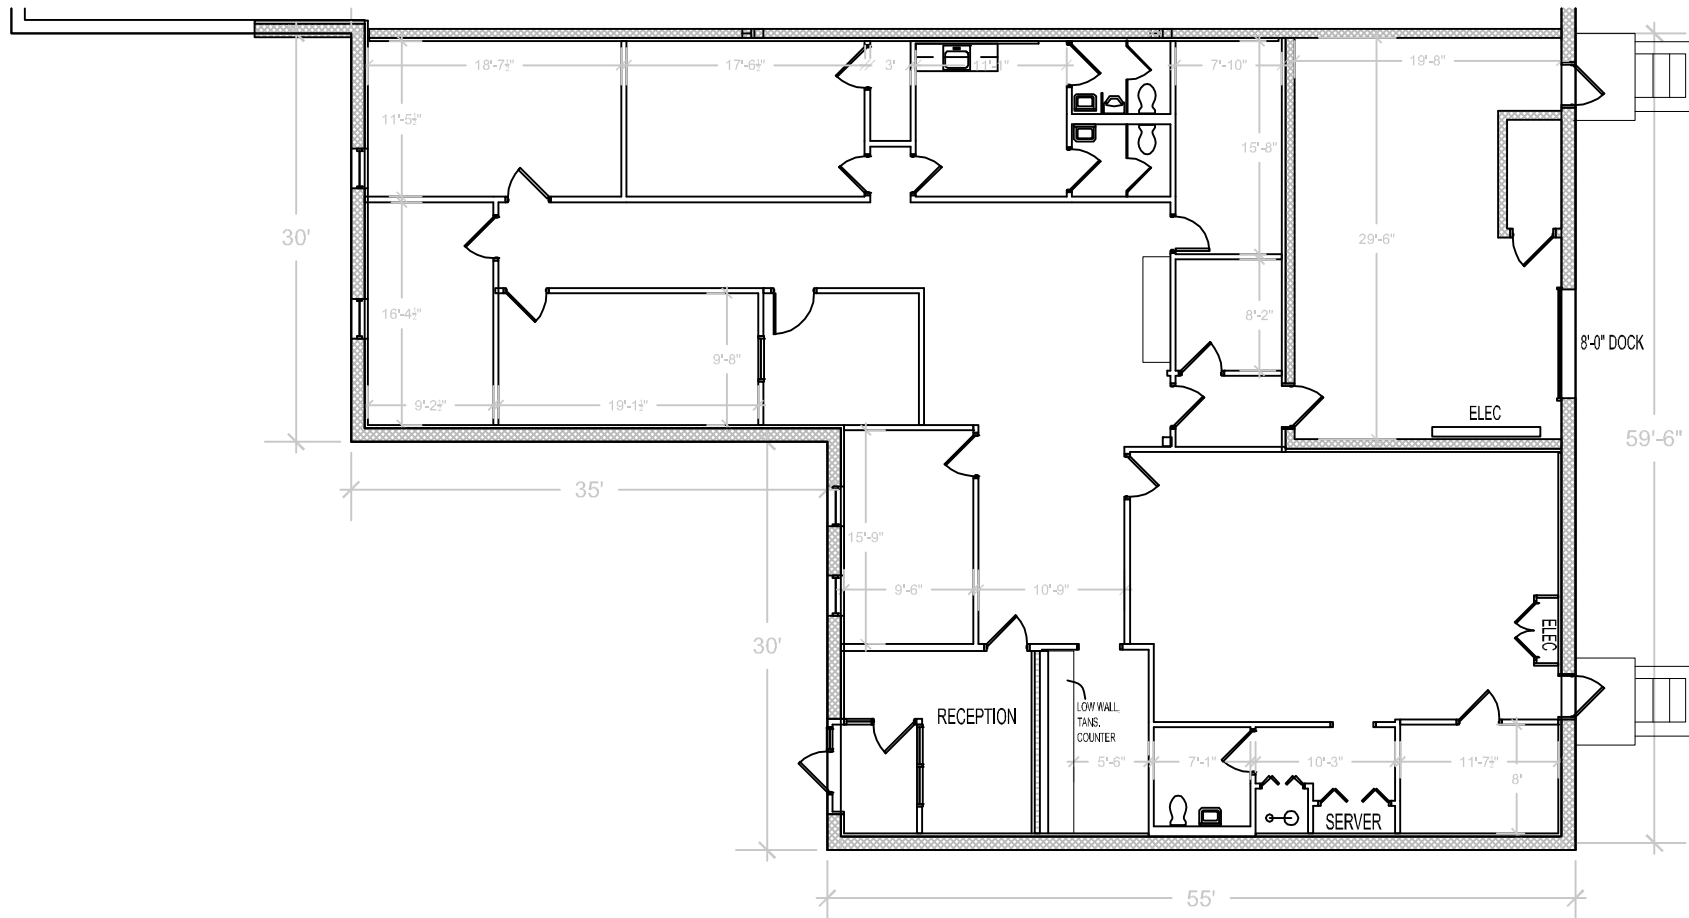

H

J