


TOTAL SF AVAILABLE - 3,600 SF


OFFICE - 1,800 SF

WAREHOUSE - 1,800 SF

[Click to access CADD file](#)

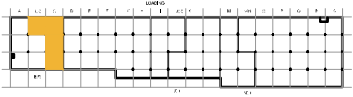

Key Plan

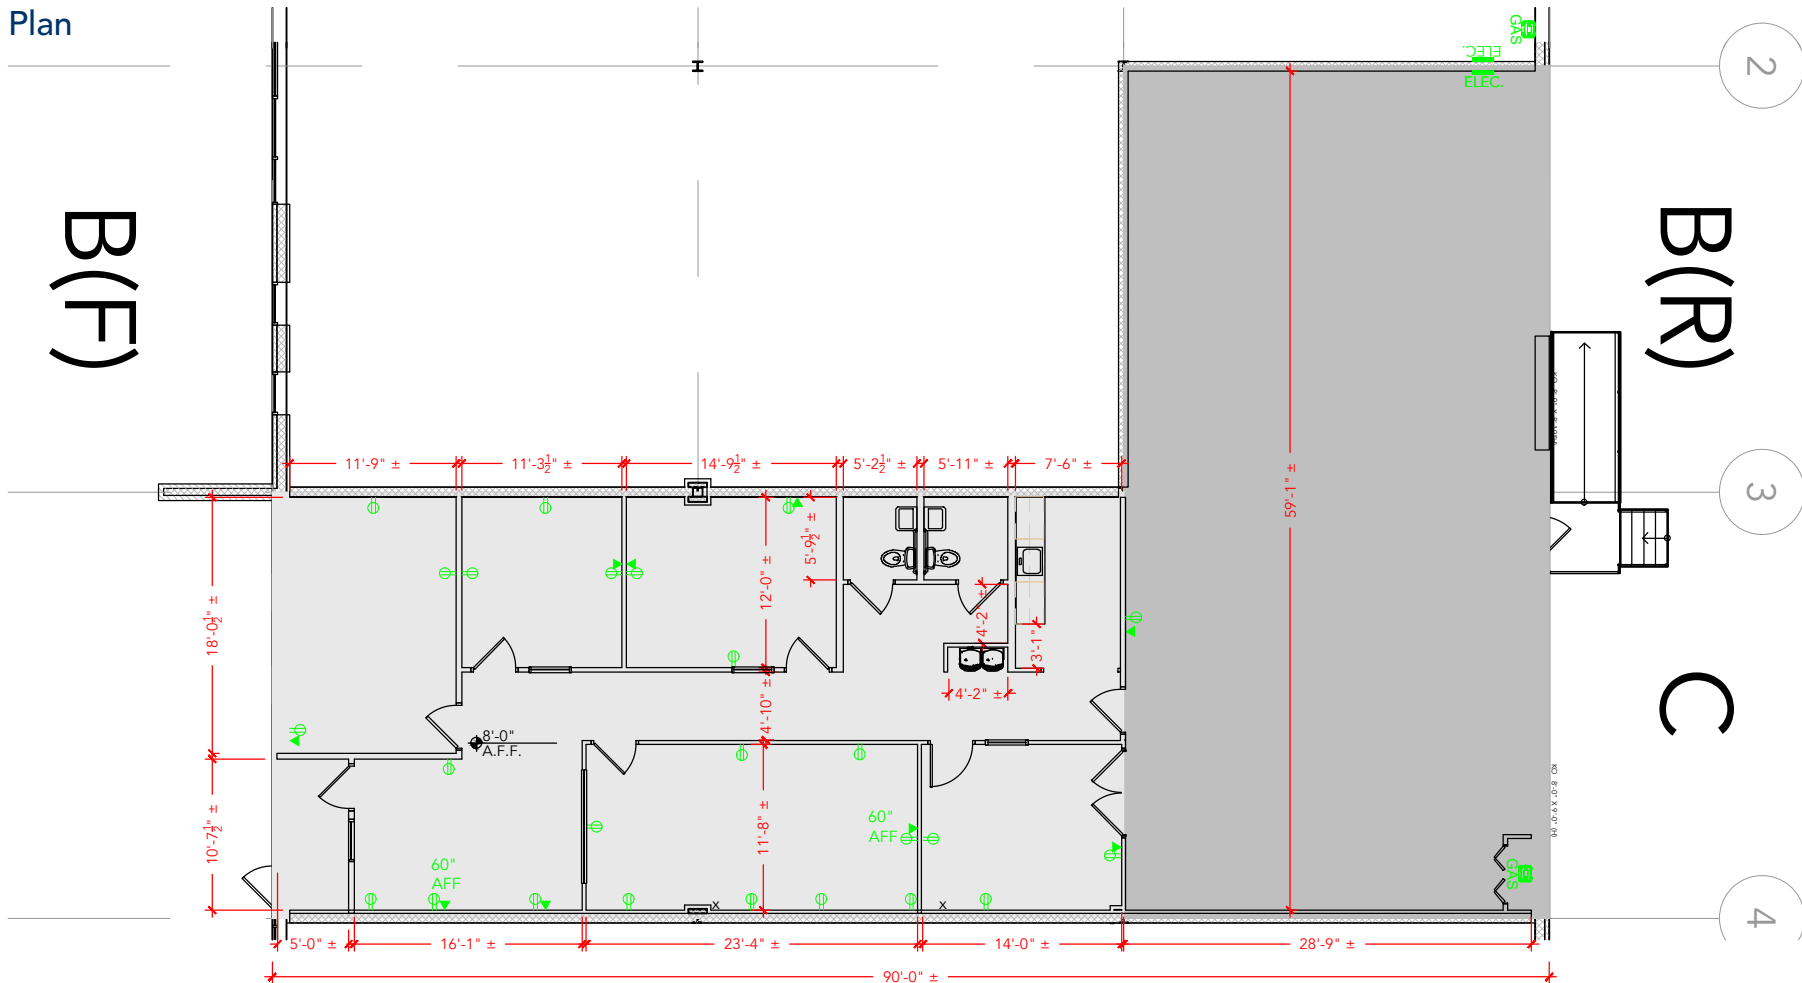

Floor Plan