


**TOTAL SF AVAILABLE -3,605 RSF**

**OFFICE - 1,799 RSF**


**WAREHOUSE - 1,806 RSF**

\* INCLUDES % OF METER ROOM

[Click to access CADD file](#)

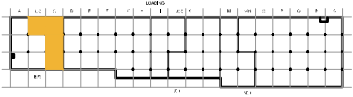

Key Plan

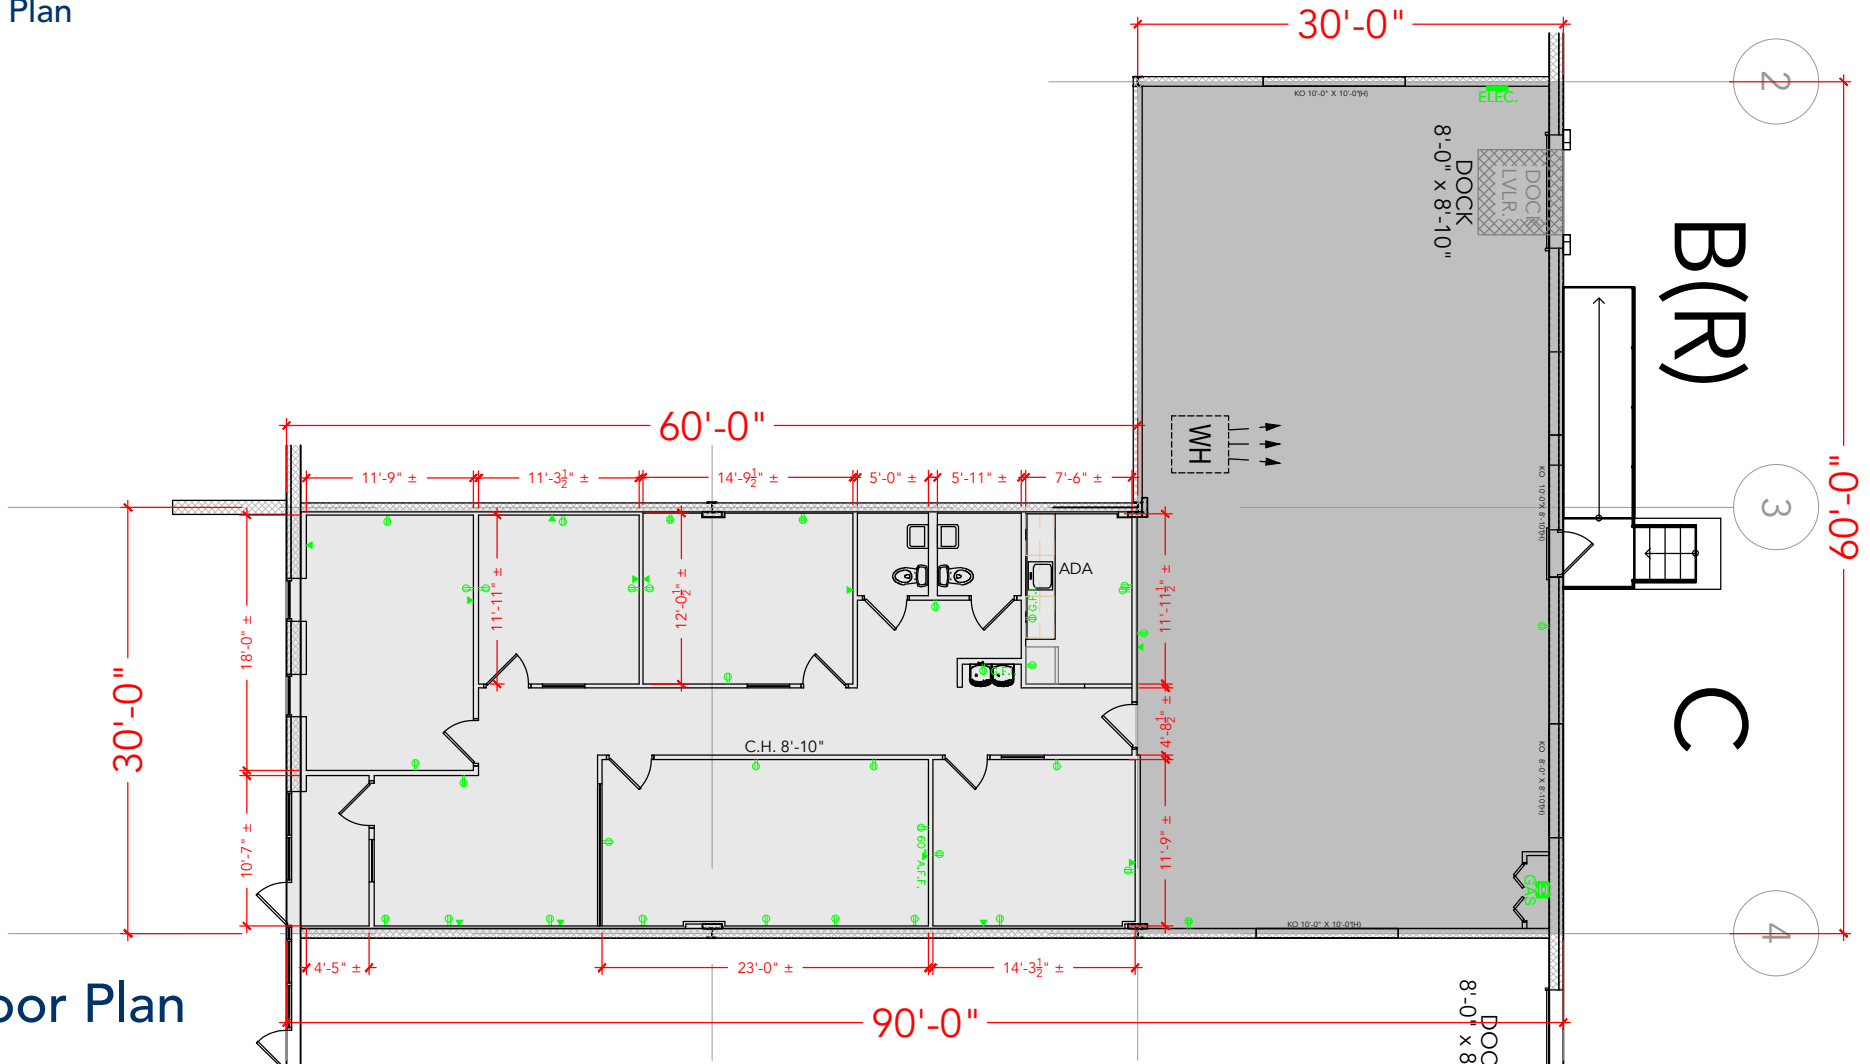

Floor Plan

PLAN NOT TO SCALE - THIS IS NOT A CONSTRUCTION DOCUMENT

DRAWING #: MP3-B(R)-CASBUILT DATE: 06.23.2026