

TOTAL SF AVAILABLE - 2,700 SF


OFFICE - 1,100 SF

WAREHOUSE SF - 1,600 SF

[Click to access 3D model](#)



Key Plan

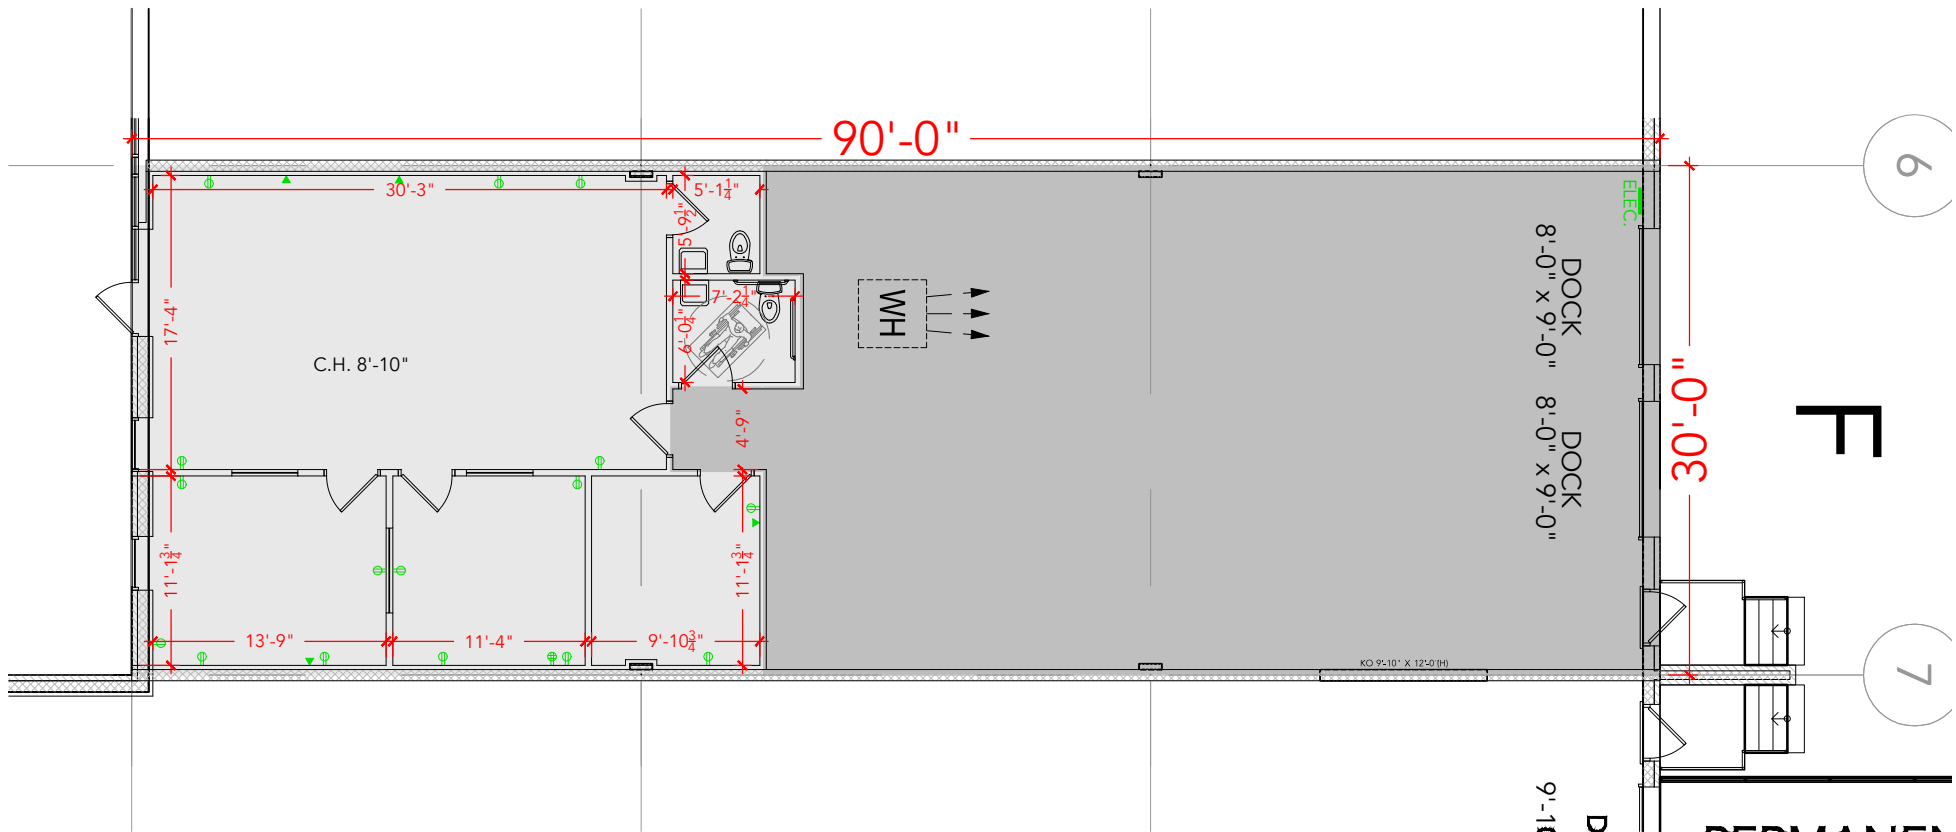

Floor Plan