


MEADOWRIDGE 95 - BUILDING 2

6518 MEADOWRIDGE RD ELKRIDGE, MD 21075 SUITE 100,124-142

TOTAL SF AVAILABLE -14,481 RSF(16%)

Click to access3D model

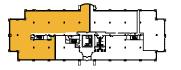

Key Plan



Floor Plan