



TOTAL SF AVAILABLE - 5,809 RSF (16%)

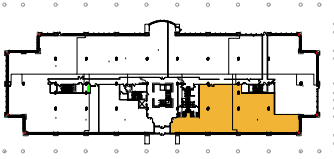

[Click to access CADD file](#)

Key Plan

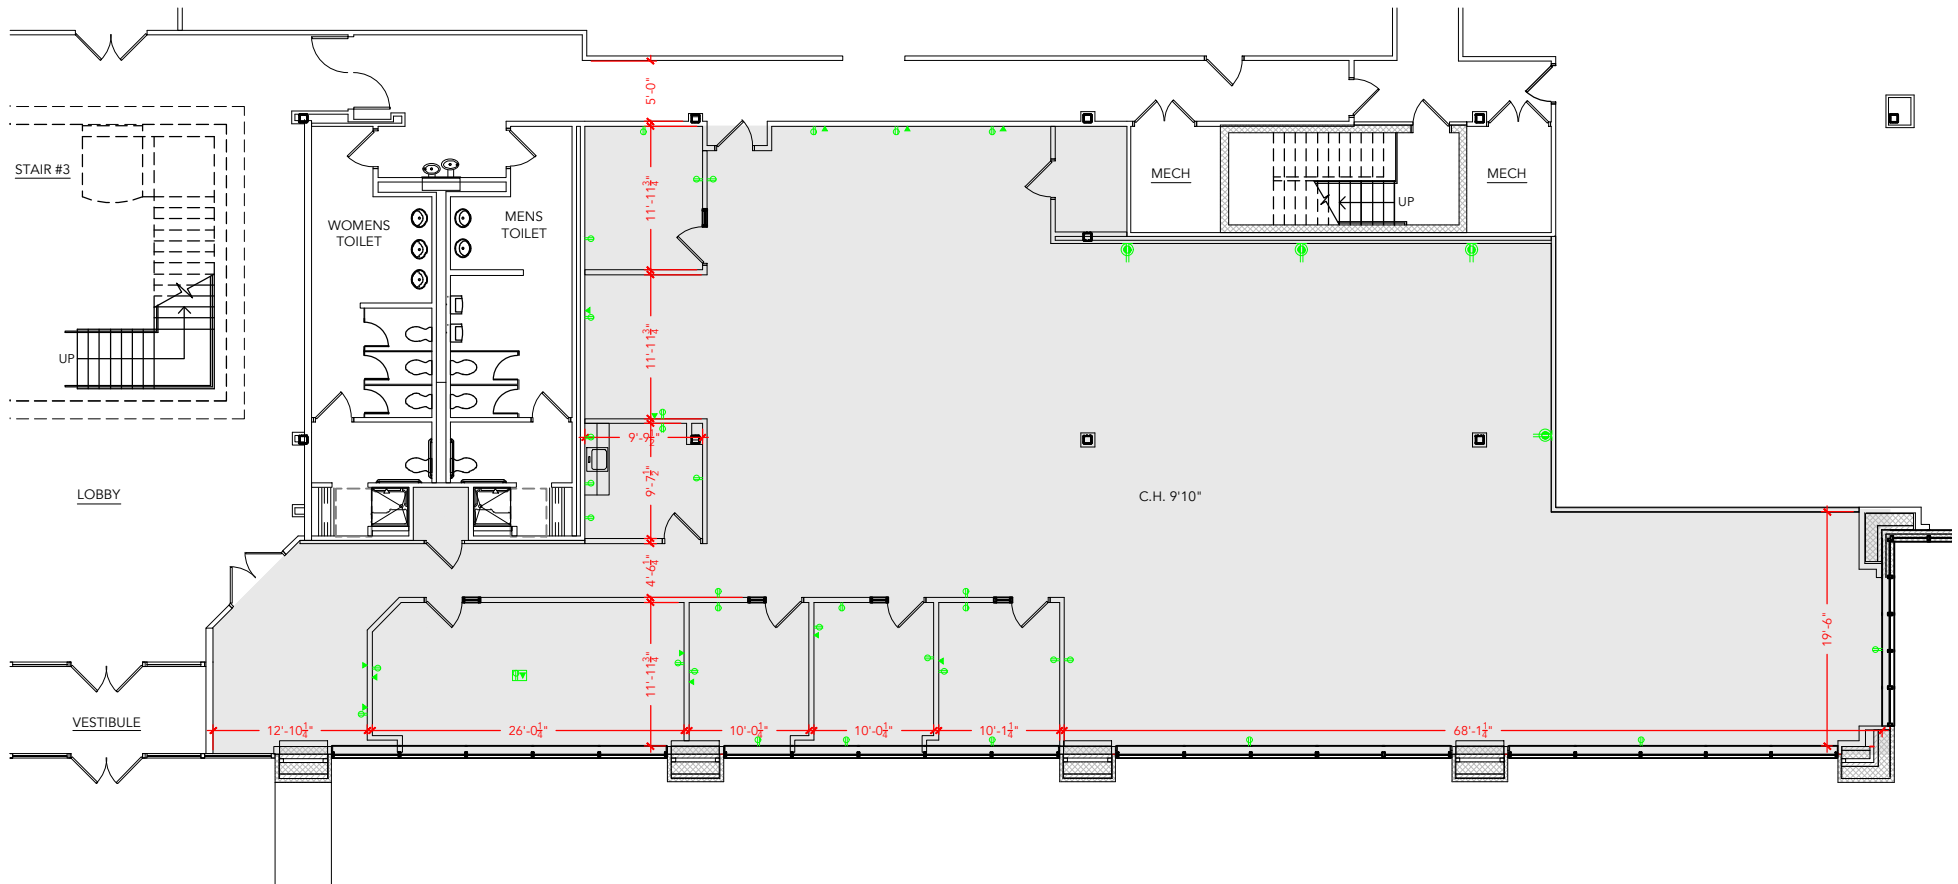

Floor Plan