



TOTAL SF AVAILABLE - 17,238 RSF(16%)

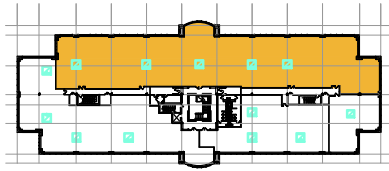

[Click to access CADD file](#)

Key Plan

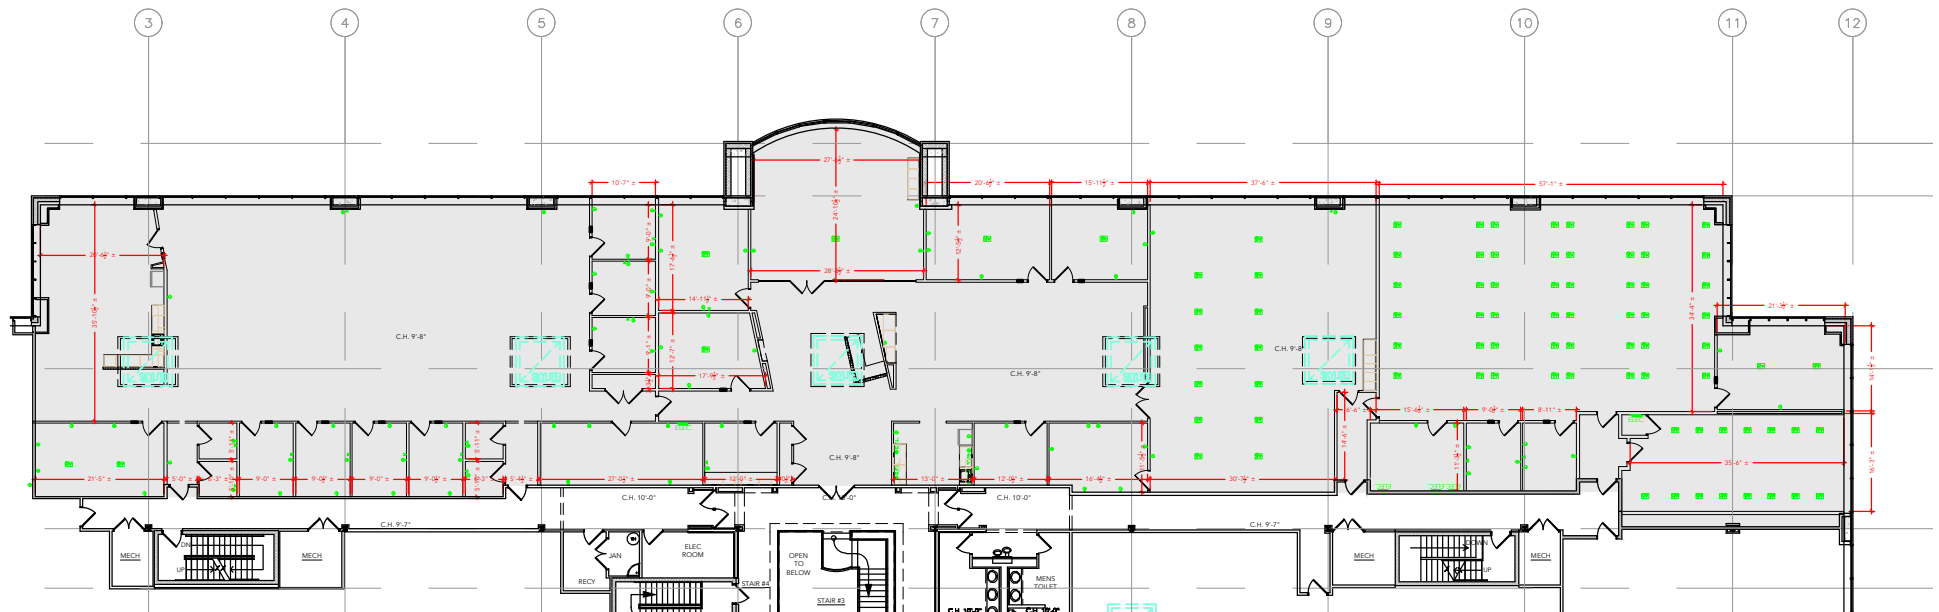

Floor Plan