



TOTAL SF AVAILABLE -30,228 RSF (16%)

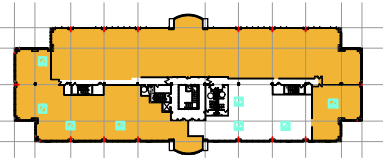

Key Plan

[Click to access CADD file](#)

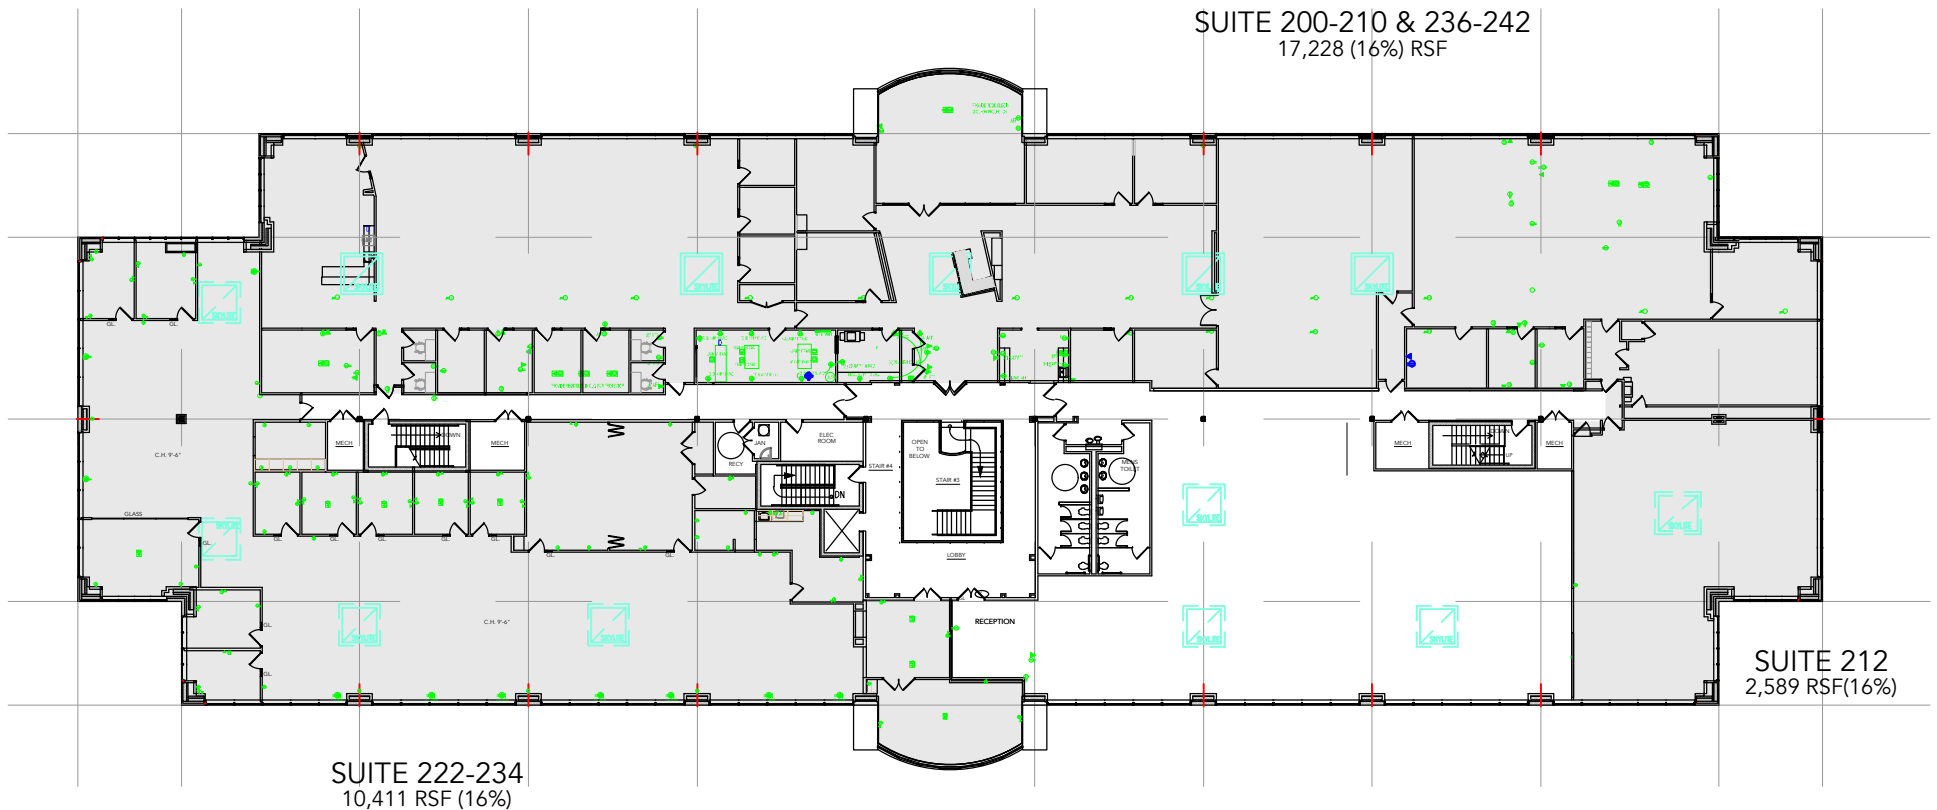

Floor Plan