


TOTAL SF AVAILABLE -35,979 RSF (16%)

[Click to access CADD file](#)

Key Plan

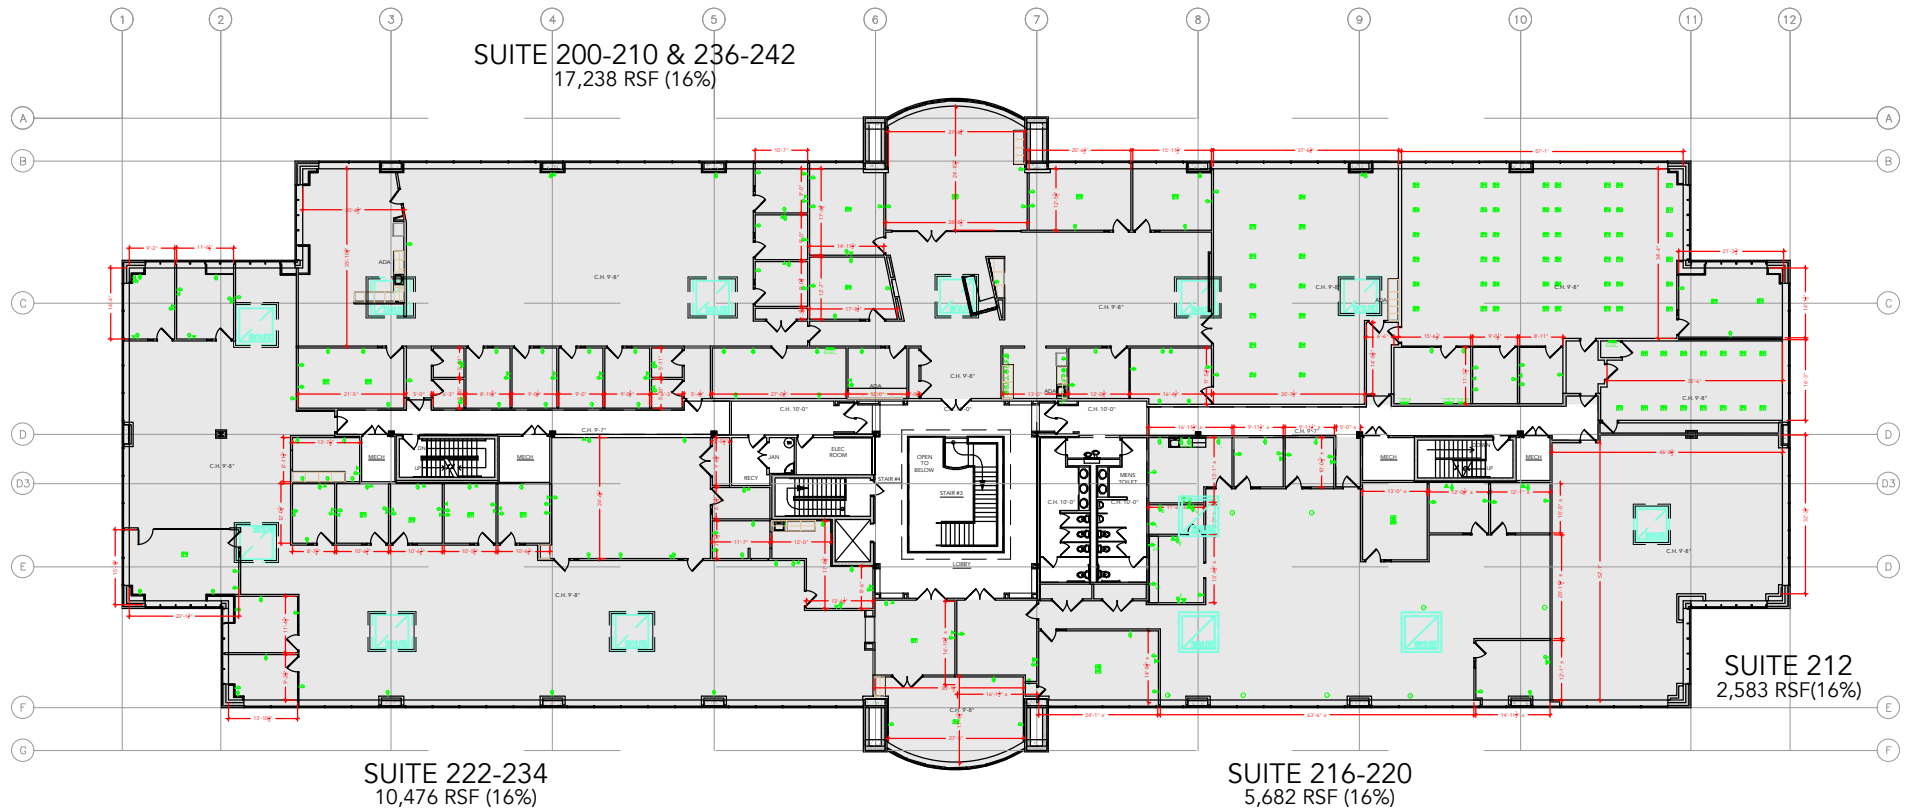

Floor Plan