



Meadowridge 95

6518 Meadowridge Road
Suites 212
Elkridge, MD 21075

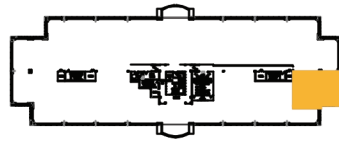

Building Key Plan

Total SF Office Available
2,515 SF

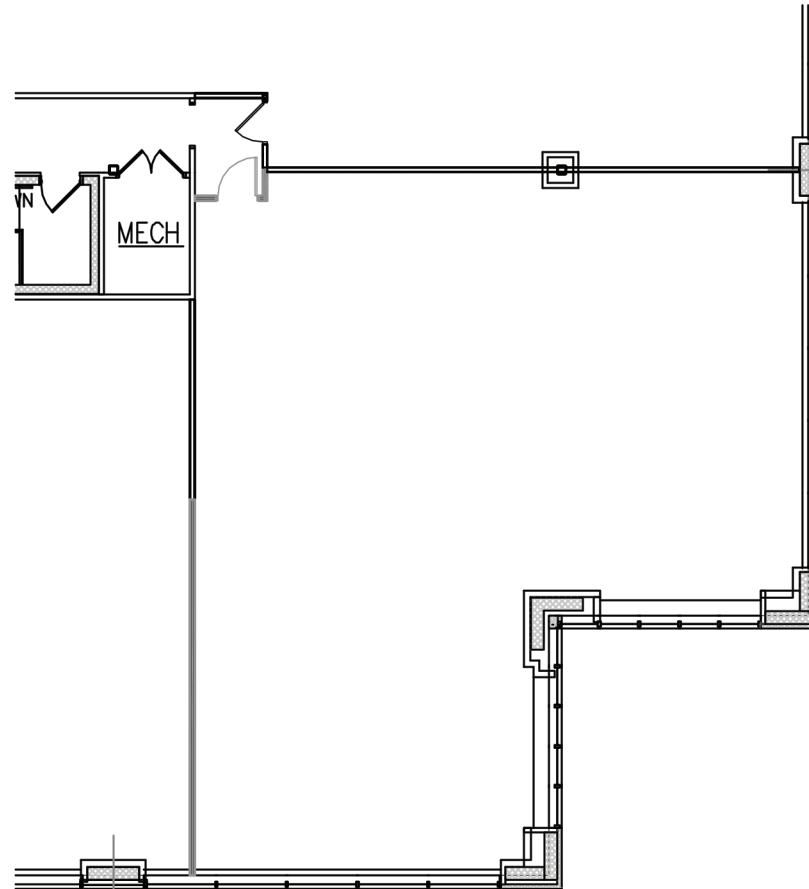

Plan not to scale - this is not a construction document.