



TOTAL SF AVAILABLE -10,476 RSF(16%)

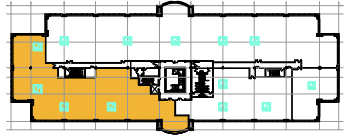

[Click to access CADD file](#)

Key Plan

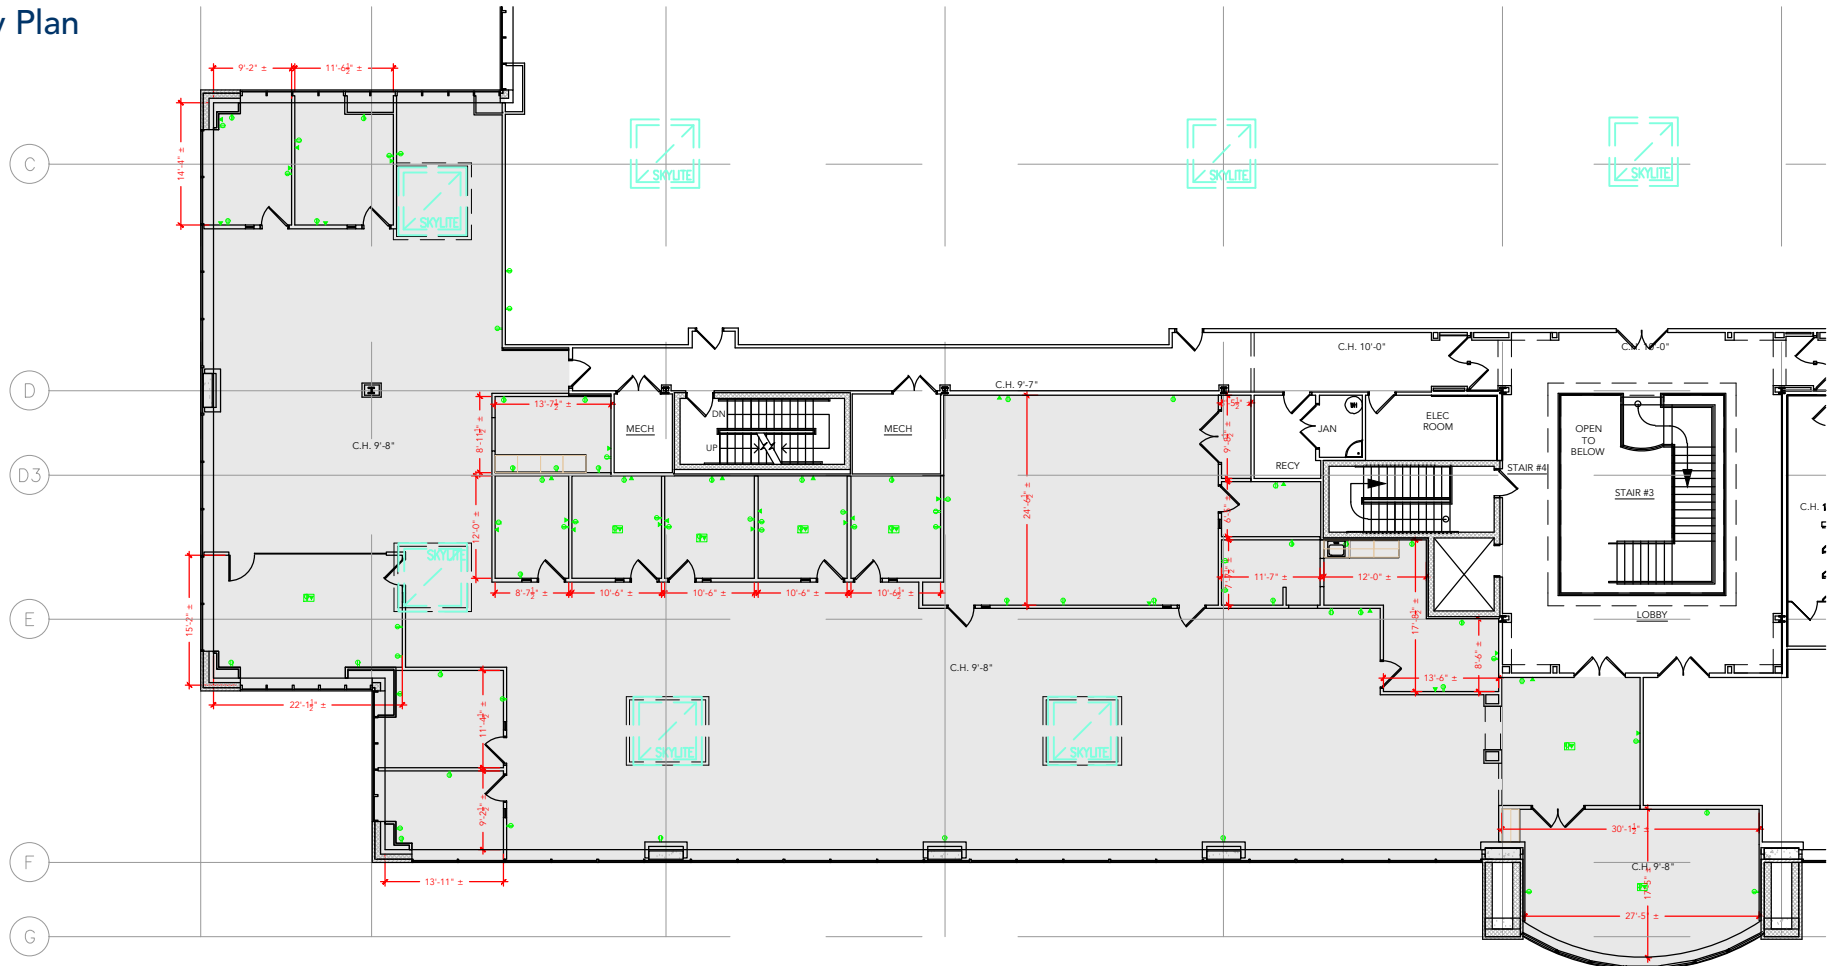

Floor Plan