


Key Plan

TOTAL SF AVAILABLE -39,022 RSF(12%)

FULL FLOOR USER - 39,022 RSF(12%)

MULTI TENANT - 36,474 RSF(16%)

[Click to access 3D model](#)

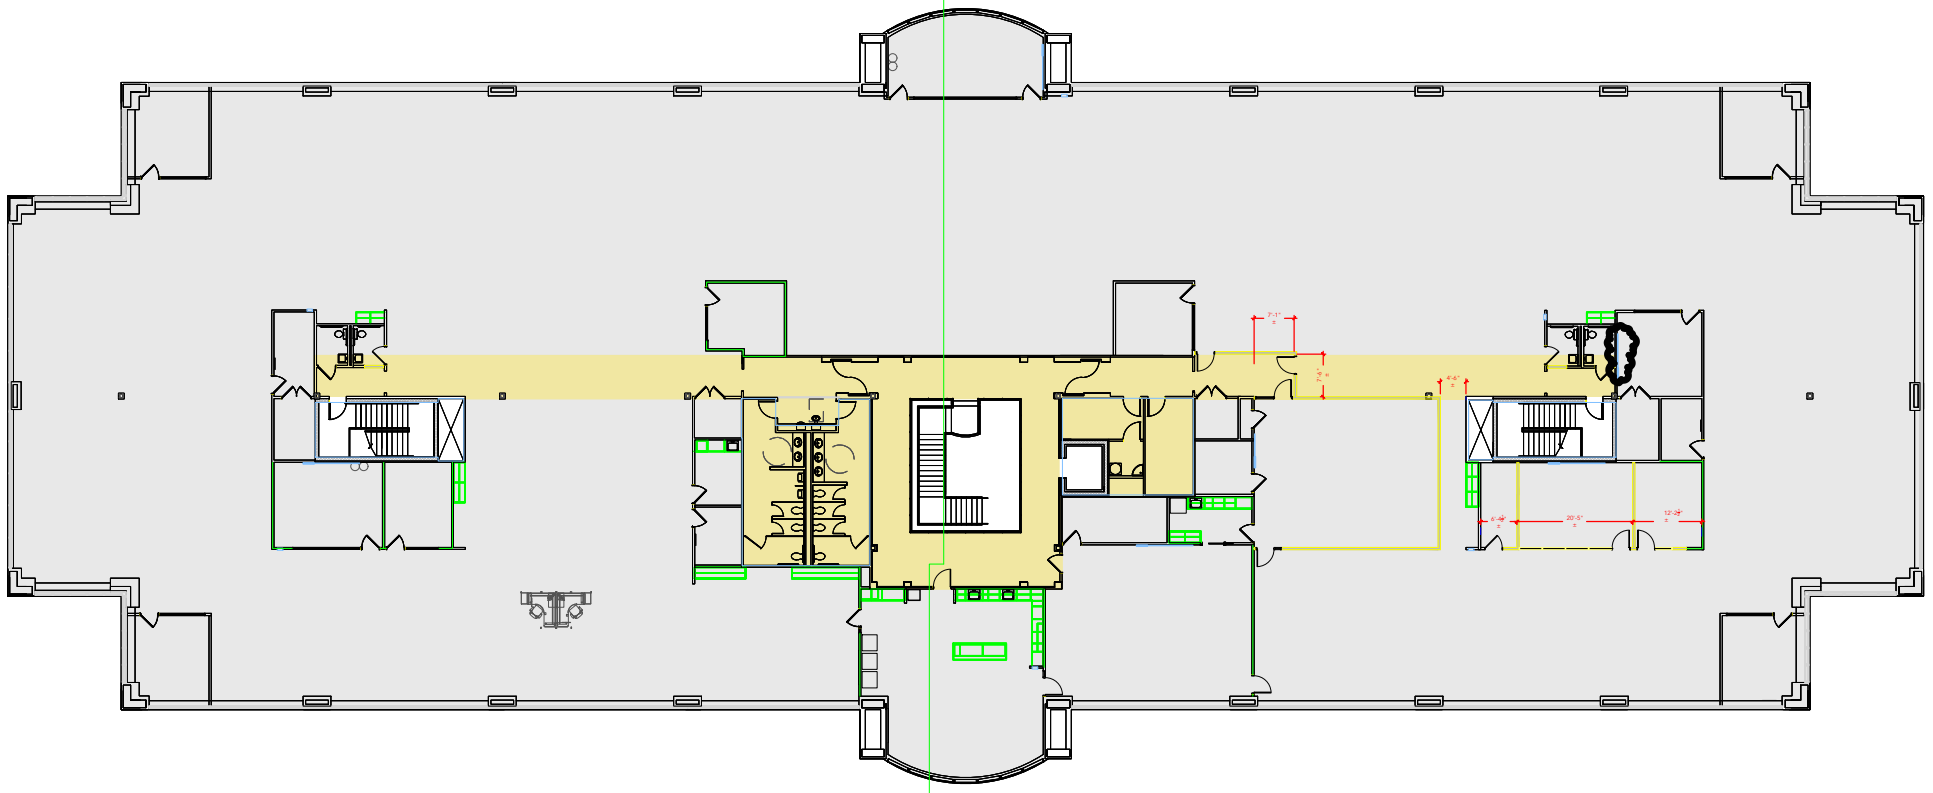


Floor Plan

TOTAL SF AVAILABLE -39,022 RSF(12%)


FULL FLOOR USER - 39,022 RSF(12%)

MULTI TENANT - 36,474 RSF(16%)

[Click to access 3D model](#)

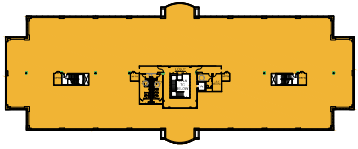

Key Plan

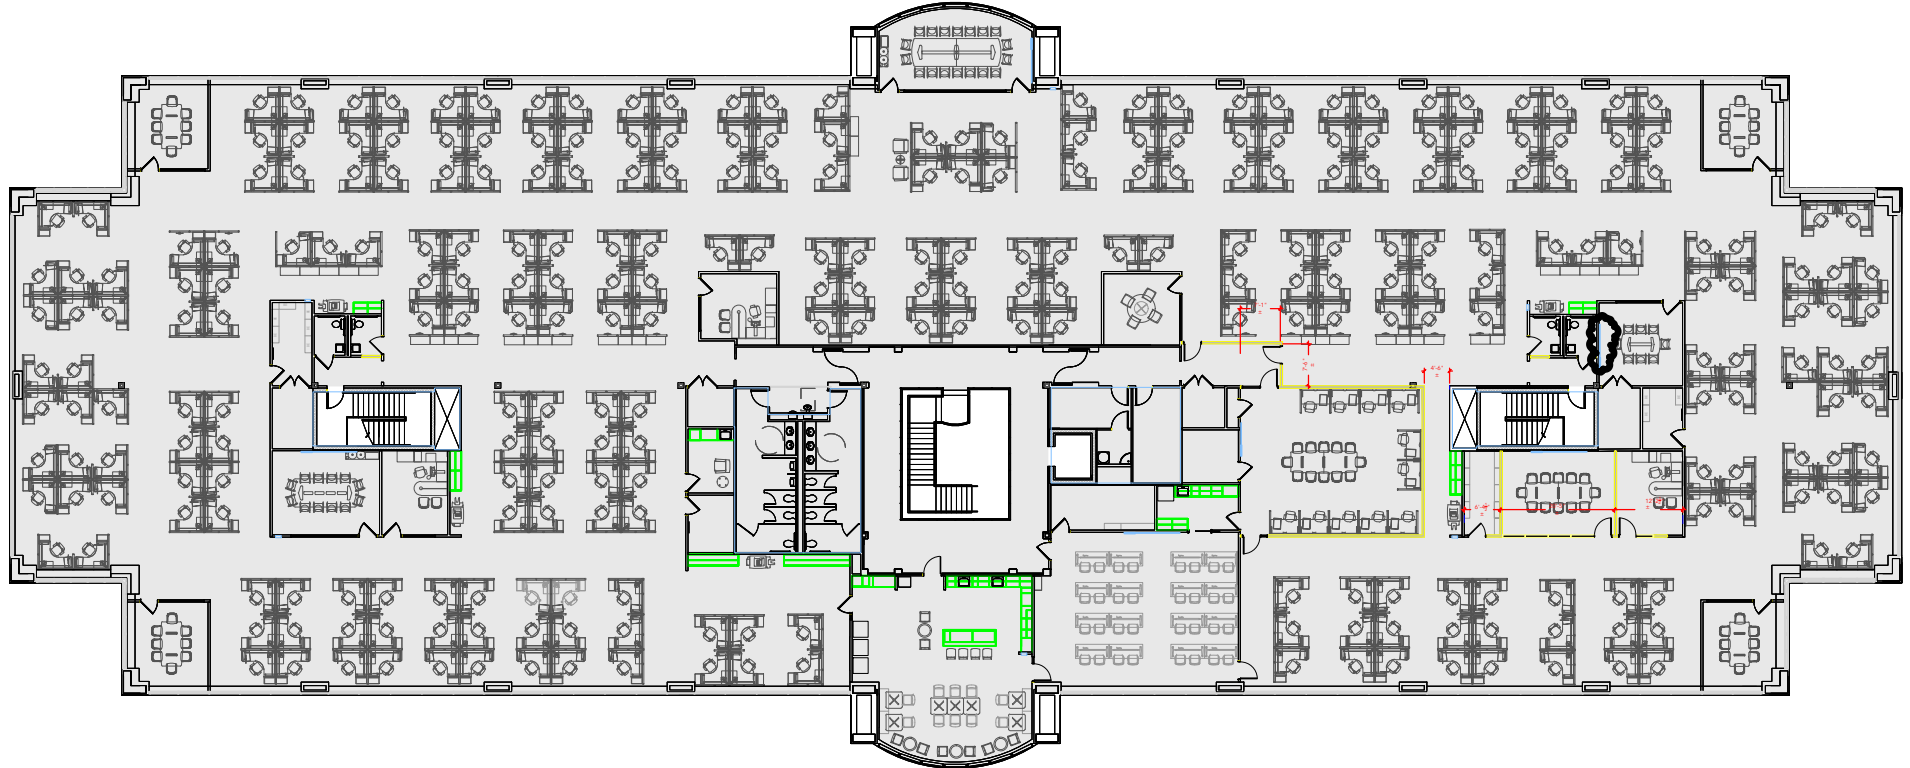

Floor Plan