



TOTAL SF AVAILABLE - 35,706 RSF(12%)

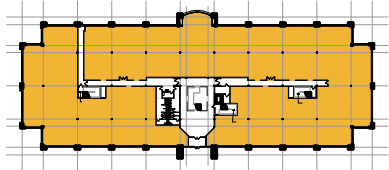

FIRST FLOOR PLAN BASED ON ARCHITECTURALS RECEIVED 06.17.19

[Click to access 3D model](#)

Key Plan

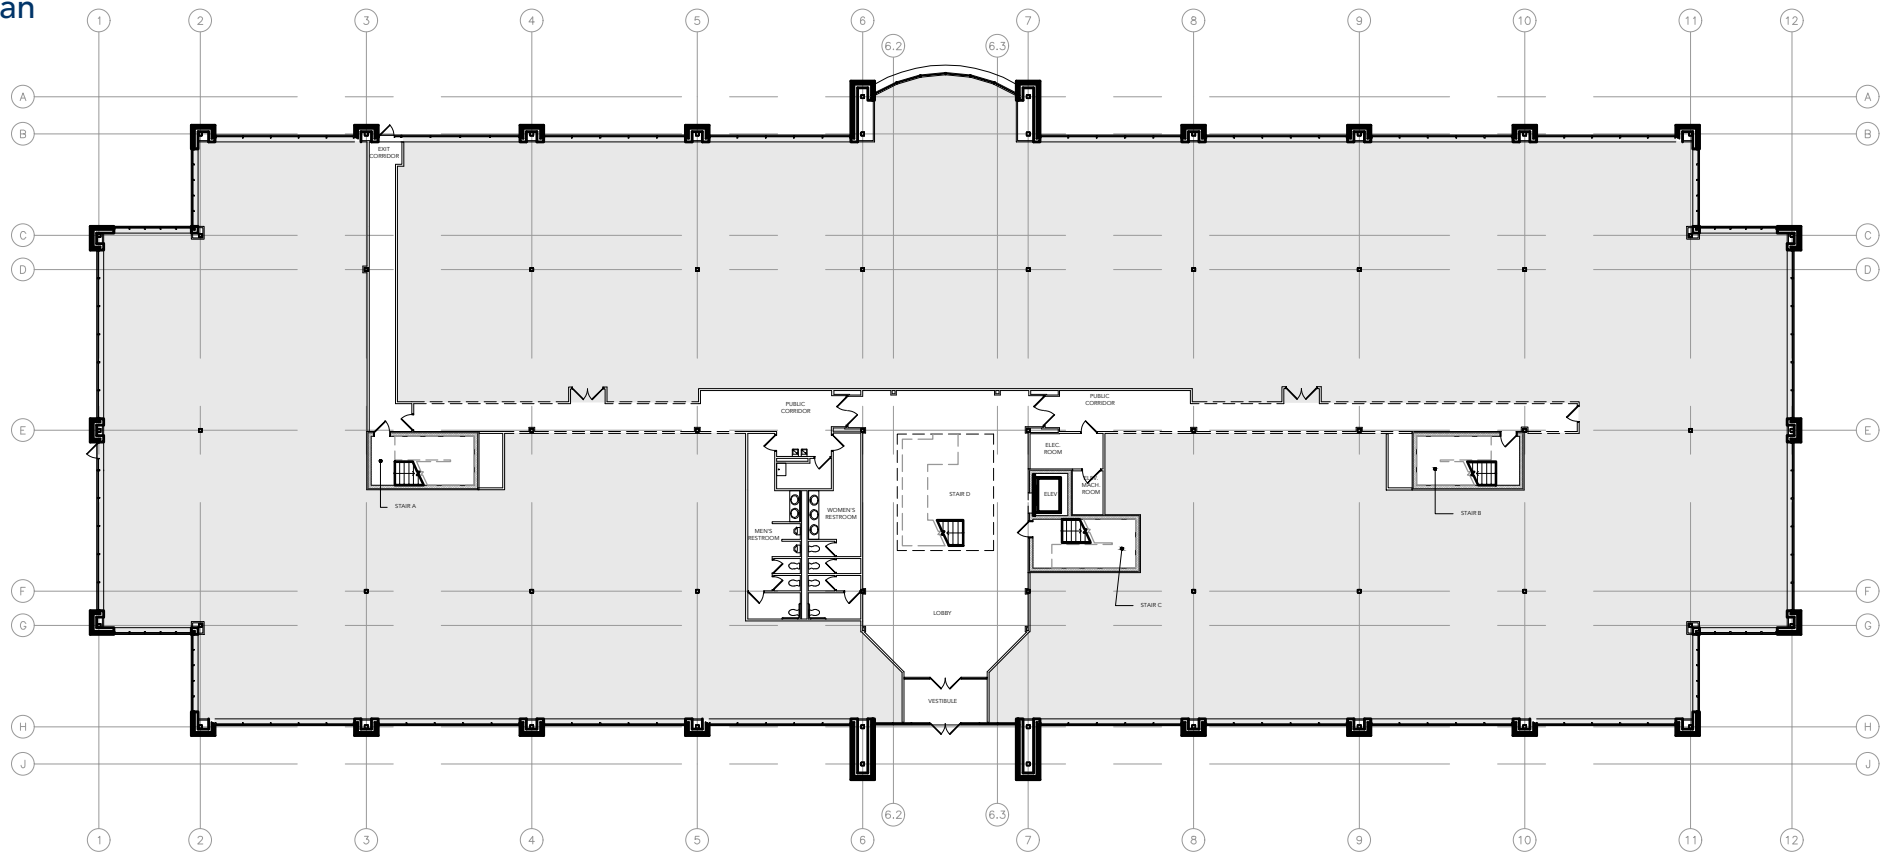

FIRST FLOOR PLAN BASED ON ARCHITECTURALS RECEIVED 06.17.19

Floor Plan