



TOTAL SF AVAILABLE - 38,688 RSF(12%)

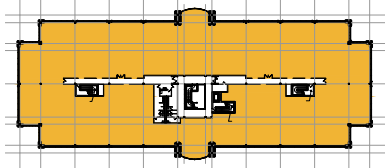

SECOND FLOOR PLAN BASED ON ARCHITECTURALS RECEIVED 06.17.19

[Click to access 3D model](#)

## Key Plan

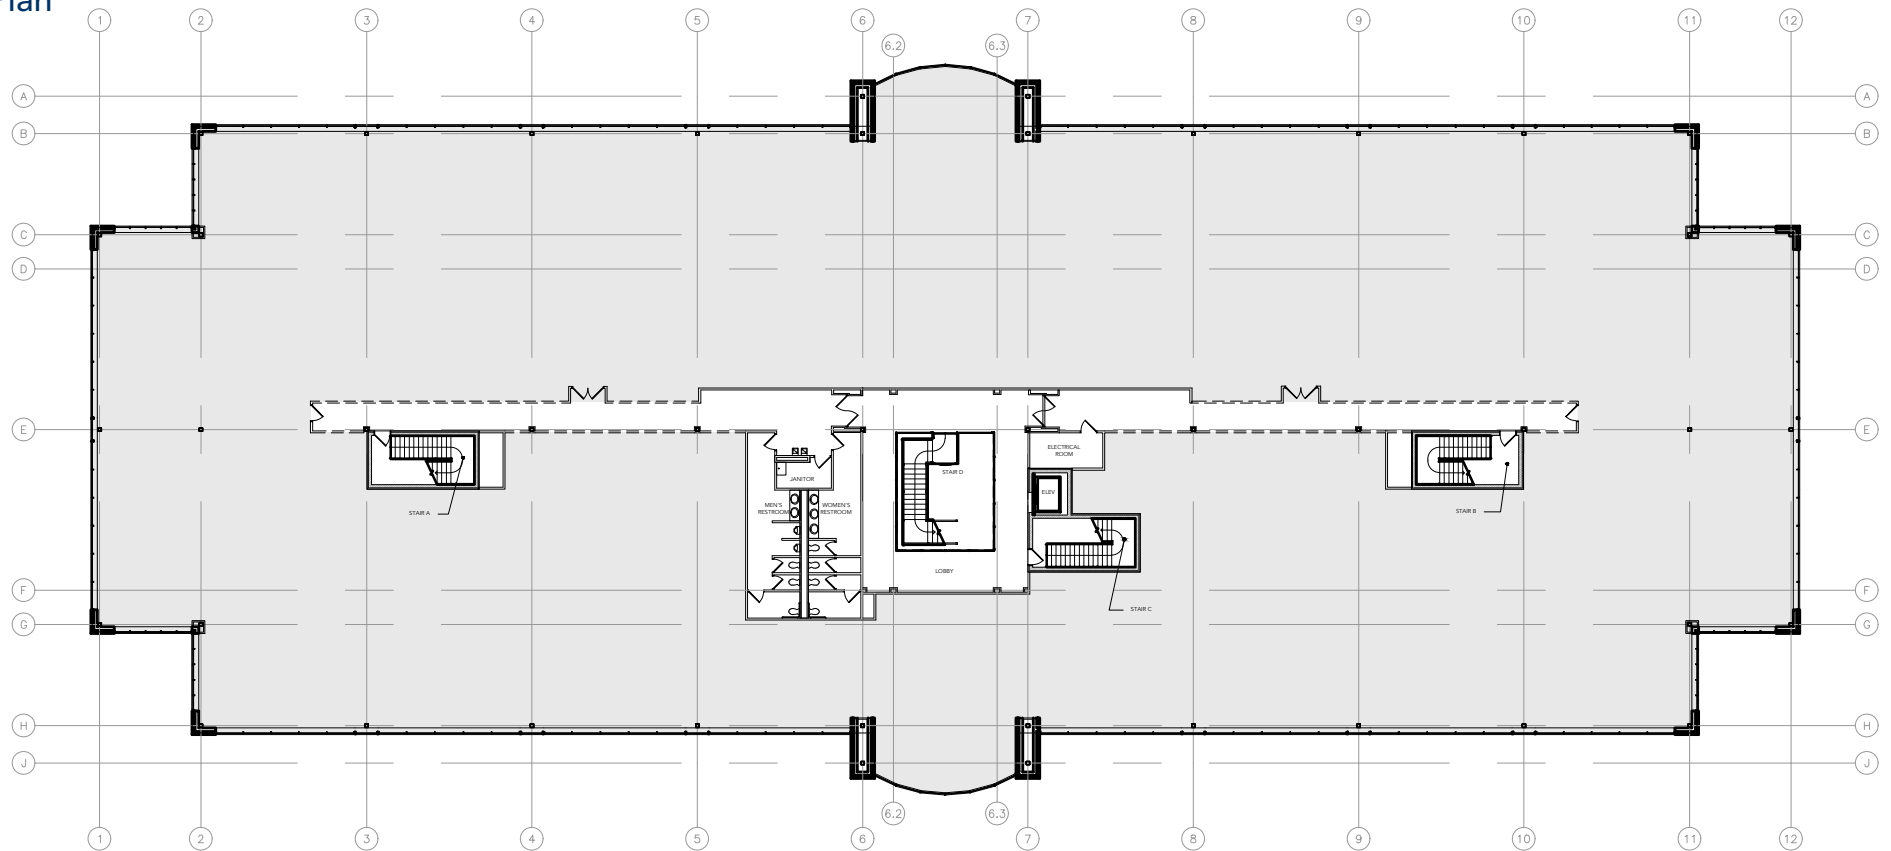

SECOND FLOOR PLAN BASED ON ARCHITECTURALS RECEIVED 06.17.19

## Floor Plan