


TOTAL SF AVAILABLE - 28,800 SF


OFFICE - 2,546 SF

WAREHOUSE - 26,254 SF

[Click to access CADD file](#)

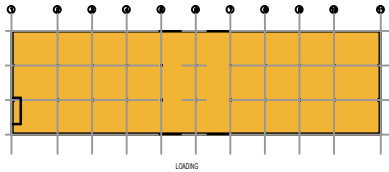

Key Plan

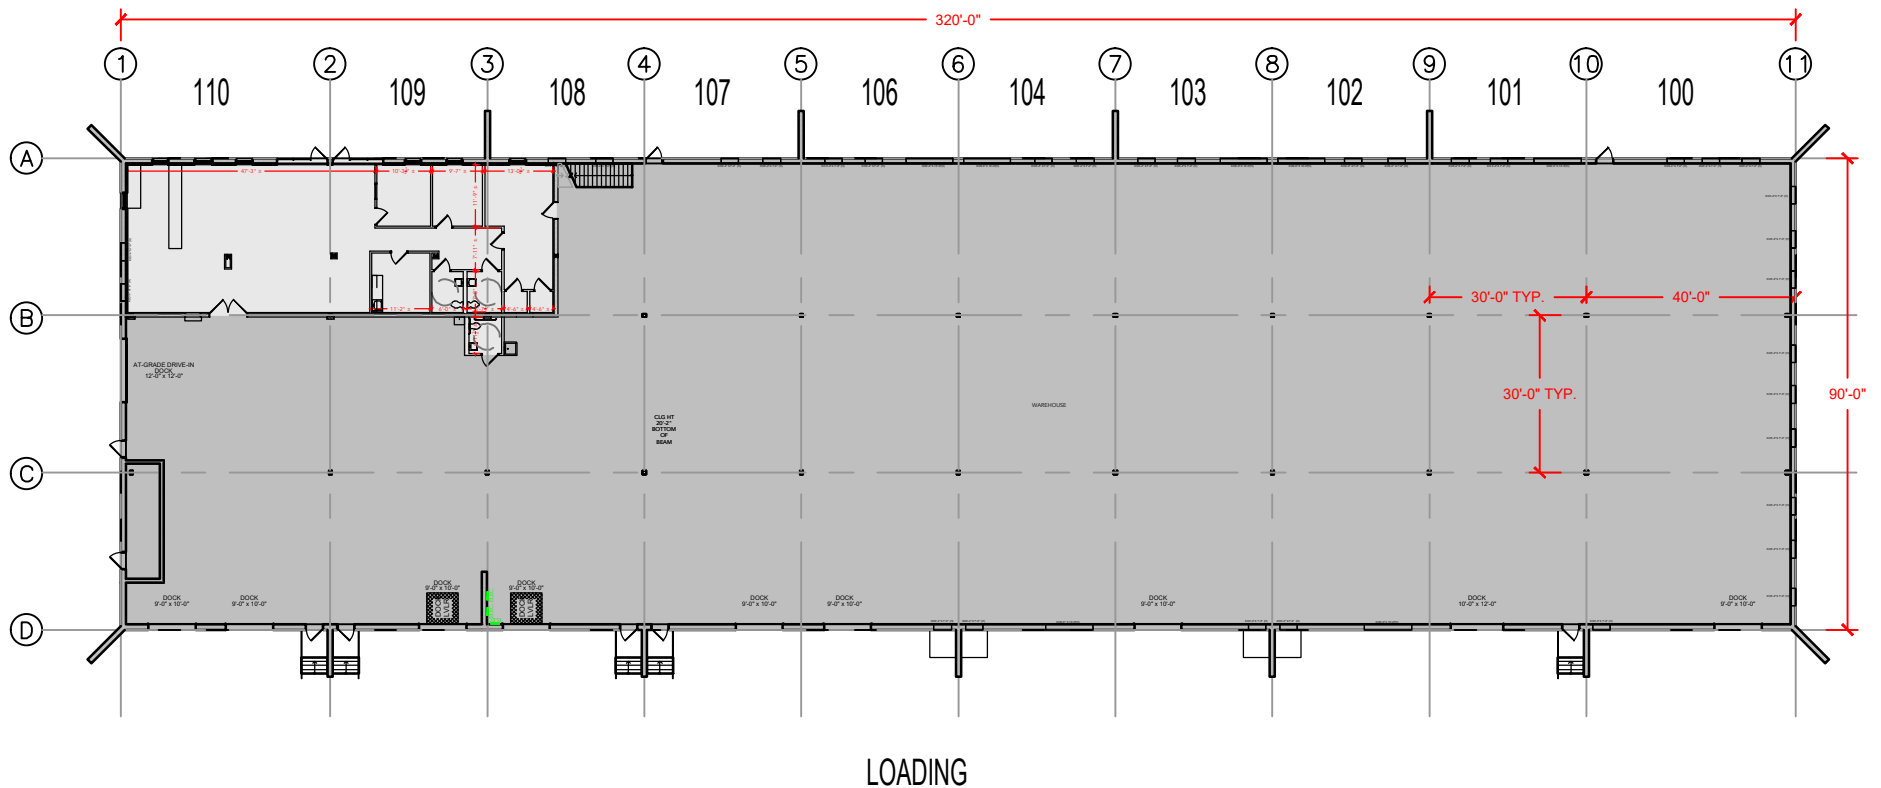

Floor Plan