


TOTAL SF AVAILABLE - 2,700 SF


OFFICE - 492 SF

WAREHOUSE - 2,208 SF

[Click to access 3D model](#)

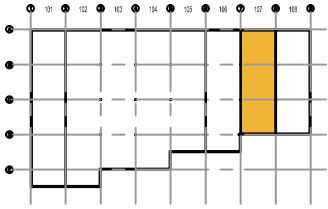

Key Plan

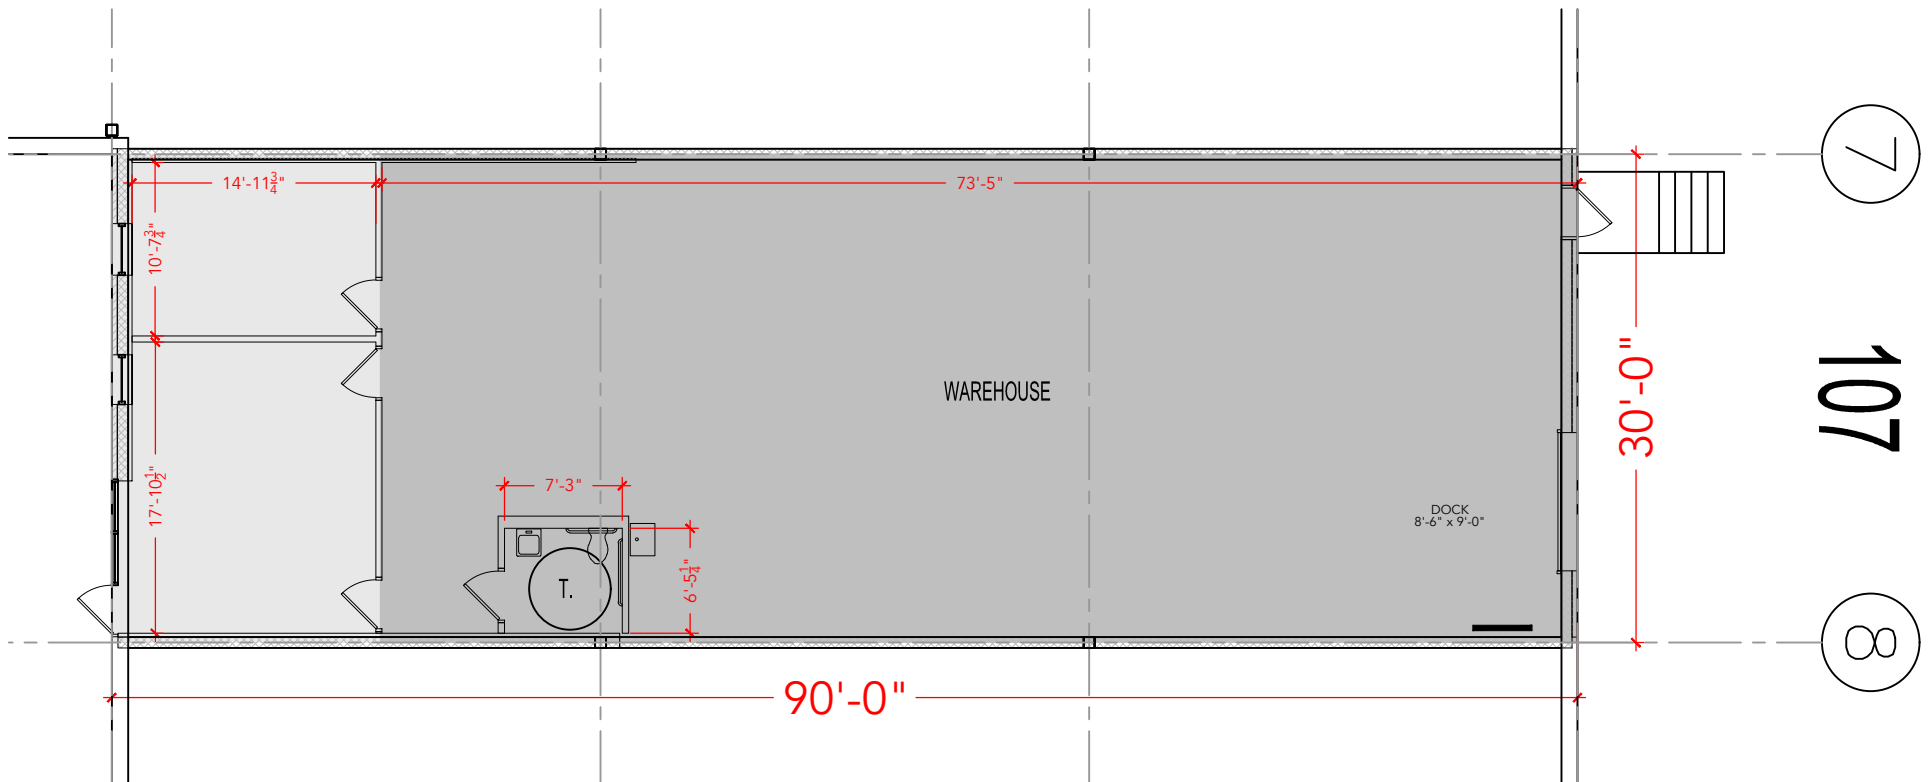

Floor Plan