


TOTAL SF AVAILABLE - 32,326 SF


OFFICE - 2,119 SF

WAREHOUSE - 30,207 SF

[Click to access CADD file](#)

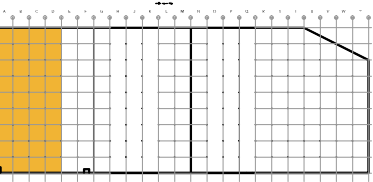

Key Plan

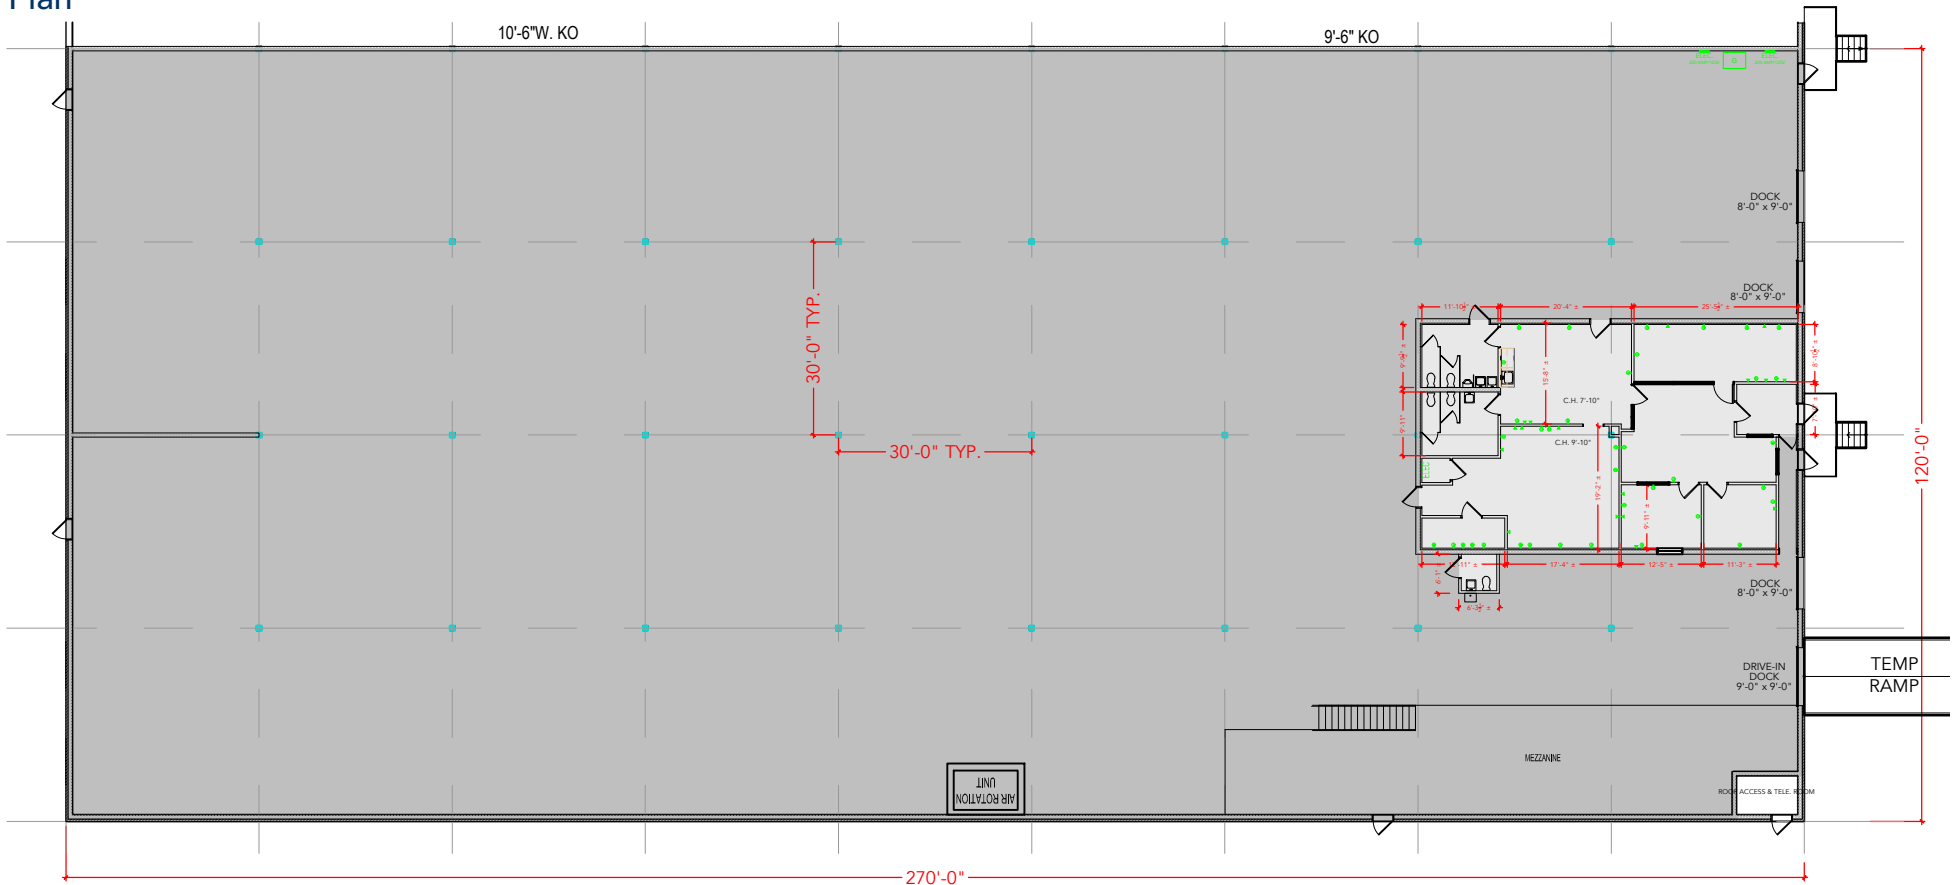

Floor Plan