


**TOTAL SF AVAILABLE -32,360 RSF**

**OFFICE - 2,121 RSF**


**WAREHOUSE - 30,239 RSF**

\* INCLUDES % OF METER ROOM

[Click to access CADD file](#)

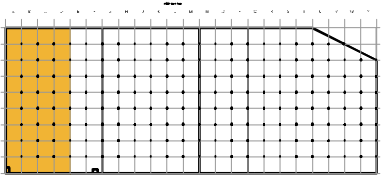

Key Plan

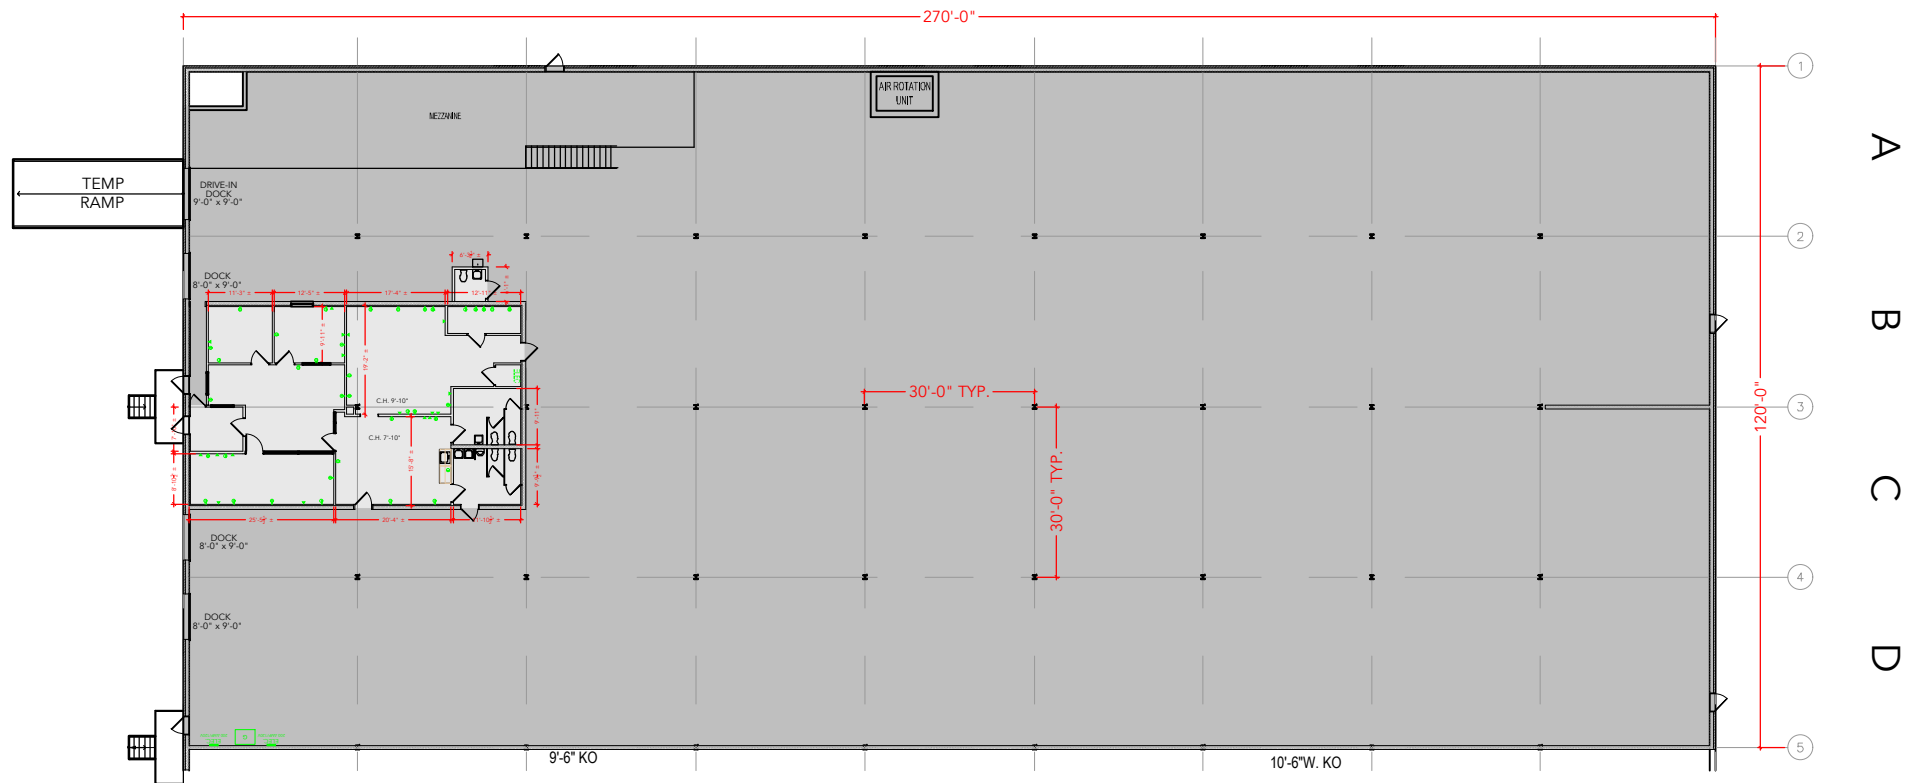

## Floor Plan