


Key Plan

TOTAL SF AVAILABLE - 16,141 SF

OFFICE - 0,000 SF
WAREHOUSE SF - 16,141 SF

[Click to access 3D model](#)

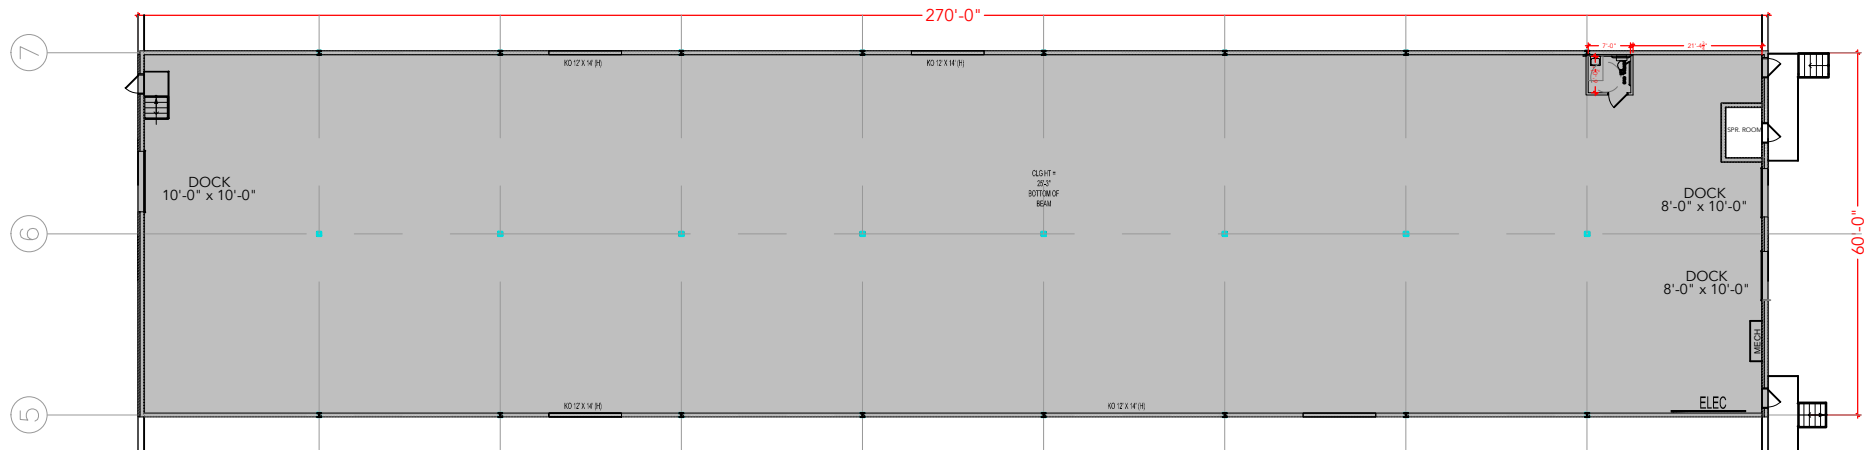

Floor Plan