


Key Plan

**TOTAL SF AVAILABLE - 16,141 SF**

OFFICE - 0,000 SF  
WAREHOUSE SF - 16,141 SF

[Click to access 3D model](#)

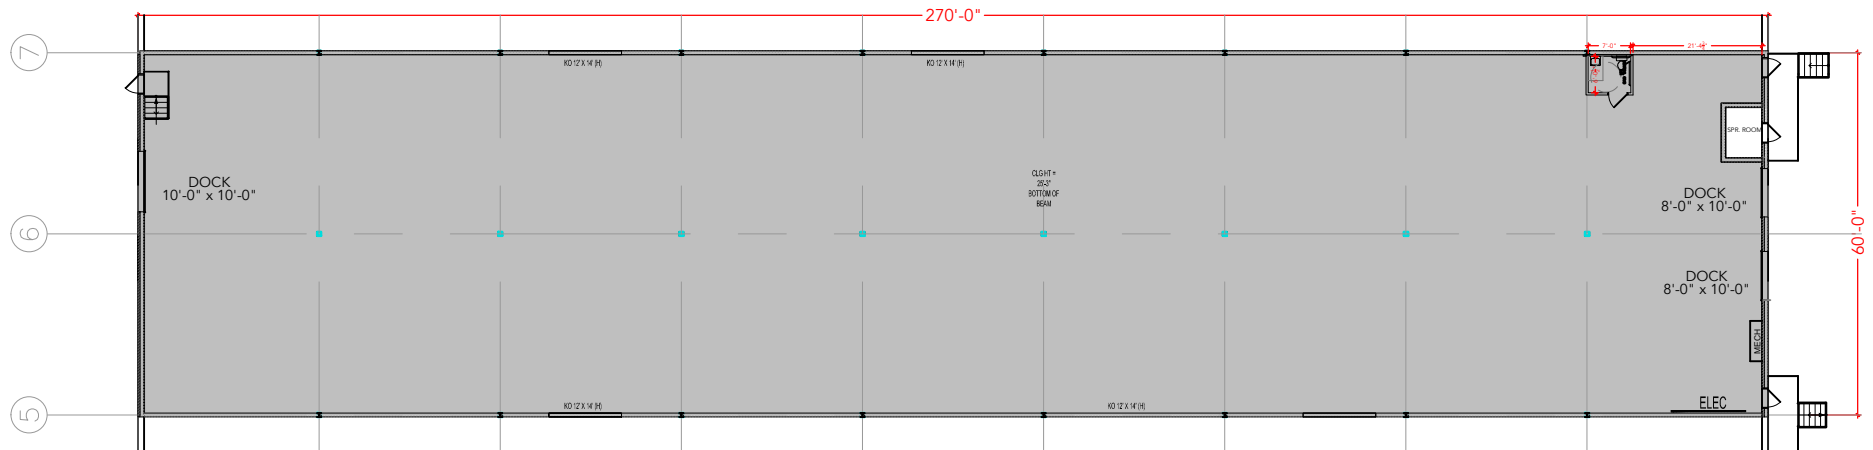

## Floor Plan